


Kingman

Form 51-5M-5-34-Palace

Map No. **KANSAS** Sec. *29* Twp. *27* R. *10^w*

Well No. *1* *Kimble* Farm
Skelly Oil Company

NORTH

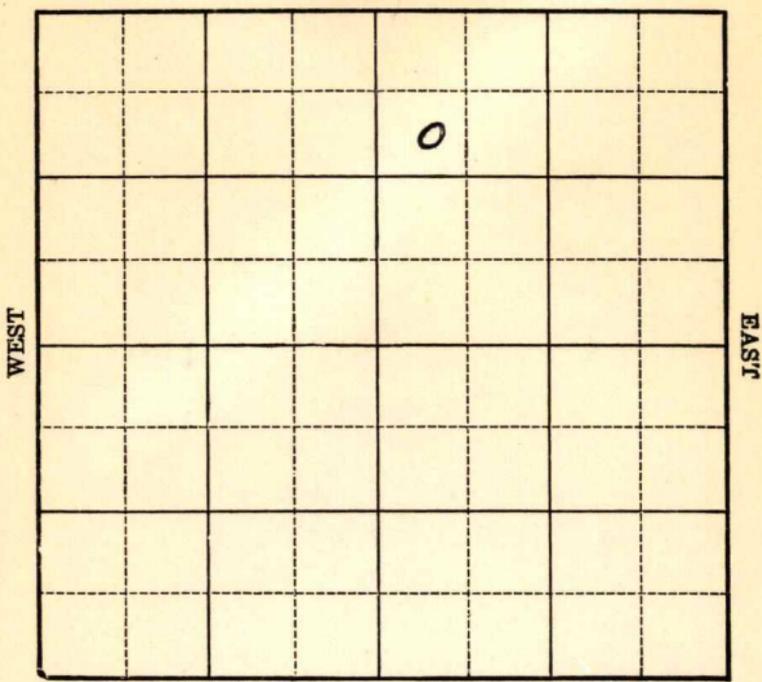

SOUTH

Location _____

Drilling Remarks _____

Rig Up _____

Drilling Remarks _____

RECORD

Cased _____ in. _____ ft.

Sand _____

Gas _____

Oil _____

Total Depth _____

PRODUCTION

1st 24 hrs. Nat. _____

1st 24 hrs. after shot _____

Gas _____ cu. ft.

Dry Hole _____

Abandoned _____

Kingman

Map No. **KANSAS** Sec. 29 Twp. 27 R. 10^w

Well No. 1 Kimble Farm


Skelly oil Company

990 Ft. from N. Line

_____ Ft. from S. Line

_____ Ft. from E. Line

440 Ft. from W. Line

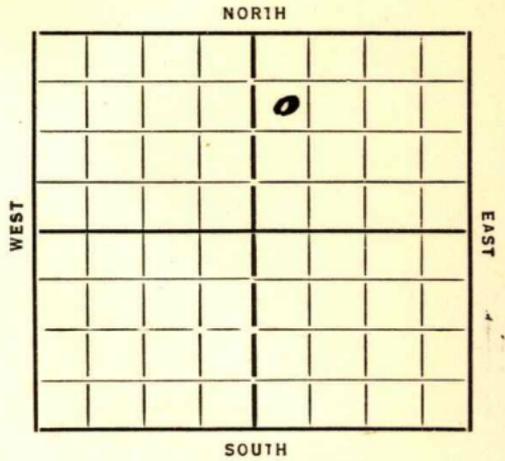

Date 1934

REPORT

8/23 Location

8/30 Bldg. Rig

9/6 Rign

9/13 12 1/2 300 WOC

9/20 Dlg 2050

9/27 3070 57 for water

10/4 Dlg 3517

10/11 Lansing 3454 T Miss 3934 -
4033 Dlg 4130

10/18 Viola 4235 4236 T7

10/24 Viola 4235 T7 4236 7 & A

ABANDONED

Map No. 54 Sec. 29 Twp. 27 R. 10W

Well No. 1-Kimble

Spelley Oil Company

Contractor

FIRST REPORTS

990 Ft. from N. Line

_____ Ft. from S. Line

_____ Ft. from E. Line

440 Ft. from W. Line

SECTION PLAT

		●	

Location ✓

Rig up _____

Drilling and Remarks:

RECORD

Cased _____ in., _____ ft.

Sand _____

Gas _____

Oil _____

Total Depth _____

PRODUCTION

1st 24 hrs. Nat. _____

1st 24 hrs. after shot _____

Gas _____ Cu. Ft.

Dry Hole _____

Abandoned _____

Date

8-23-31 19

ORVAL MANNSCHRECK
Scout

Map No. 54 Sec. 29 Twp. 27 R. 10W

Well No. 1-Kimble

Spelly Oil Company

Contractor

ABANDONED

SECTION PLAT

990 Ft. from N. Line

_____ Ft. from S. Line

_____ Ft. from E. Line

440 Ft. from W. Line

		0	

Location _____

Rig up _____

Drilling and Remarks:

10 + FF

RECORD

Cased _____ in., _____ ft.

Sand Woln 4235

Gas _____

Oil _____

Total Depth 4236

PRODUCTION

1st 24 hrs. Nat. _____

1st 24 hrs. after shot _____

Gas _____ Cu. Ft.

Dry Hole _____

Abandoned _____

Date

10-24-34 19

ORVAL MANNSCHRECK

Scout