

Map No. _____ Sec. 30 Twp. 27 R. 10-W


Well No. 1-Intourban Realty Co Farm
Skelly oil Company

440 Ft. from N. Line

_____ Ft. from S. Line

_____ Ft. from E. Line

1320 Ft. from W. Line

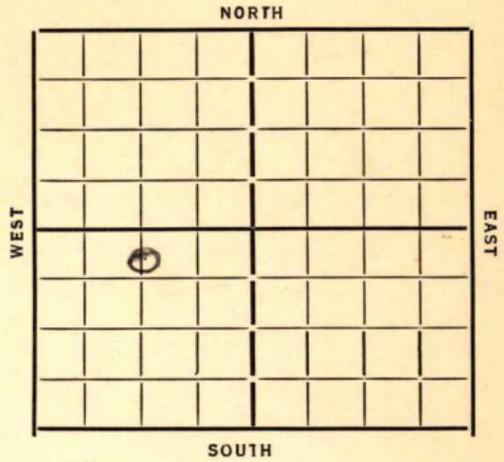

Date	REPORT
1933	
8/2	location
8/9	—
8/17	—
8/23	—
8/30	Pond
9/6	Rig up
9/13	12" at 250 woc
9/20	Drily 2620'
9/29	Tap Lansing 3407-TD 3417-show oil
10/5	3410' 7" Drily plug
10/11	Oil 3410-TD 3452. flow
	235 bbls 24 hrs-will acidize
10/18	Plug back to 3448-will treat
	with 1000 gal acid
10/25	T. Lansing 3407
	T. D. 3452 P. B. 3448
	1000 gal acid
	flow 431 bbls 7 hrs

COMPLETED

Map No. 54 Sec. 30 Twp. 27 R. 10W

Well No. 1-Interurban Realty Co

Spelly oil Company

Contractor


SECTION PLAT

440 Ft. from N. Line

Ft. from S. Line

Ft. from E. Line

1320 Ft. from W. Line

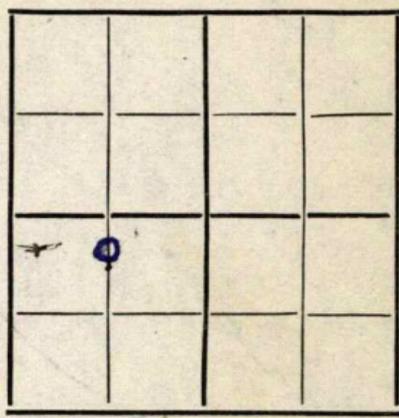

FIRST REPORTS

Location

Rig up

Drilling and Remarks:

RECORD

Cased in., ft.

Sand

Gas

Oil

Total Depth

PRODUCTION

1st 24 hrs. Nat.

1st 24 hrs. after shot

Gas Cu. Ft.

Dry Hole

Abandoned

Date

8/7/33 192 Coalman Scout


Kingman

Map No. *54* Sec. *30* Twp. *27* R. *10W*

Well No. *1-Interurban Realty*
Skelly Oil Company

Contractor

SECTION PLAT

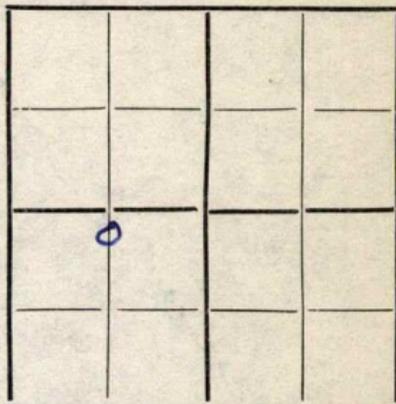

440 Ft. from N. Line

Ft. from S. Line

Ft. from E. Line

1320 Ft. from W. Line

COMPLETED

Location

Rig up

Drilling and Remarks:

P. B. 3448
1000 gal acid

flow 431 bbls
7 hours

RECORD

Cased in, ft.

Sand *Lansing 3407*

Gas

Oil

Total Depth *3452*

PRODUCTION

1st 24 hrs. Nat.

1st 24 hrs. after shot

Gas Cu. Ft.

Dry Hole

Abandoned

Date

10-25-33 192 *O. Mammescheck* Scout