


Map No. **KANSAS** Sec. **30** Twp. **27** R. **10<sup>W</sup>**

Well No. **2-Interurban** Farm \_\_\_\_\_

**Shelly Oil** Company \_\_\_\_\_

NORTH

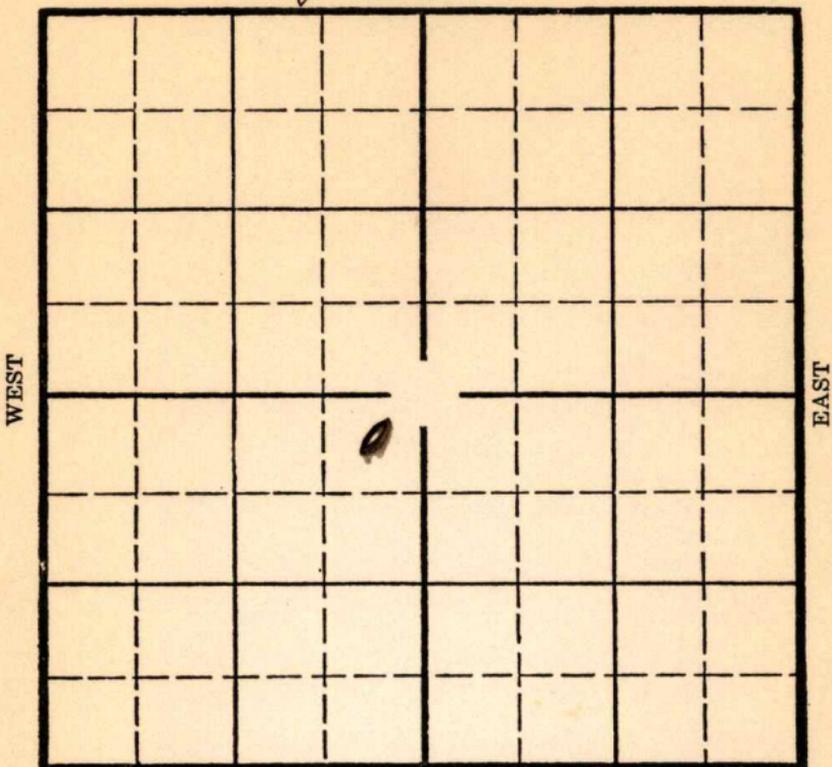

WEST

EAST

SOUTH

Location \_\_\_\_\_  
Drilling Remarks \_\_\_\_\_

Rig Up \_\_\_\_\_  
Drilling Remarks \_\_\_\_\_

RECORD

Cased \_\_\_\_\_ in. \_\_\_\_\_ ft.  
Sand \_\_\_\_\_  
Gas \_\_\_\_\_  
Oil \_\_\_\_\_  
Total Depth \_\_\_\_\_

PRODUCTION


1st 24 hrs. Nat. \_\_\_\_\_  
1st 24 hrs. after shot \_\_\_\_\_  
Gas \_\_\_\_\_ cu. ft. \_\_\_\_\_  
Dry Hole \_\_\_\_\_  
Abandoned \_\_\_\_\_

Kingman  
27 10W

Map No. KANSAS Sec. 30 Twp. 27 R. 10W

Well No. 2- Interrurban Farm  
Skelly oil Company

330 Ft. from N. Line  
Ft. from S. Line  
440 Ft. from E. Line  
Ft. from W. Line

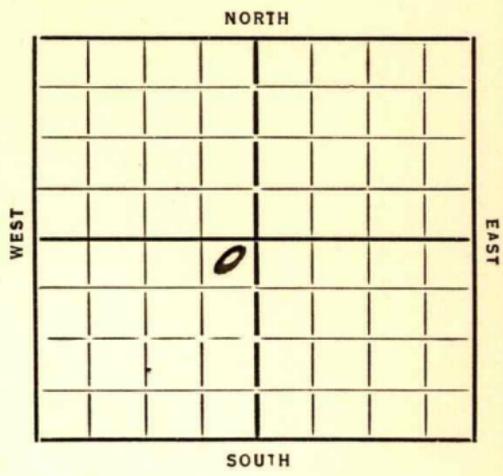

Date 7/25

REPORT

7/17 Location  
8/8 15" 240  
8/15 dly 2695  
8/22 Lansing 3402  
8/29 3406 shut  
9/6 dly 3440  
9/20 KC 3402  
T7 3447  
1000 acid  
216 Pbls.

COMPLETED

Map No. 54 Sec. 30 Twp. 27 R. 10W

Well No. 2-Interrurban

Spelly Oil Company

Contractor

FIRST REPORTS

SECTION PLAT

330 Ft. from N. Line

..... Ft. from S. Line

440 Ft. from E. Line

..... Ft. from W. Line

	0		

Location

Rig up .....

Drilling and Remarks:

RECORD

Cased..... in., ..... ft.

Sand .....

Gas .....

Oil .....

Total Depth.....

PRODUCTION

1st 24 hrs. Nat.....

1st 24 hrs. after shot.....

Gas..... Cu. Ft.

Dry Hole.....

Abandoned.....

Date

7-17-35 192

ORVAL MANNSCHECK Scout

Map No. 54 Sec. 30 Twp. 27 R. 10<sup>w</sup>

Well No. 2-Interurban

Spelly oil

Company

Contractor

COMPLETED

SECTION PLAT

	0		

330 Ft. from N. Line

..... Ft. from S. Line

440 Ft. from E. Line

..... Ft. from W. Line

Location.....

Rig up.....

Drilling and Remarks:

1000 and

216 bbls

RECORD

Cased..... in., ..... ft.

Sand BC 3402

Gas.....

Oil.....

Total Depth 3447

PRODUCTION

1st 24 hrs. Nat.....

1st 24 hrs. after shot.....

Gas..... Cu. Ft.

Dry Hole.....

Abandoned.....

Date

9-20-35

192

ORVAL MANNSCHRECKE

Scout