


KANSAS

KINGMAN

Section 30 Township 27 Range 10W

Well Number #3 ~~X~~ Interurban Realty

Company Skelly Oil

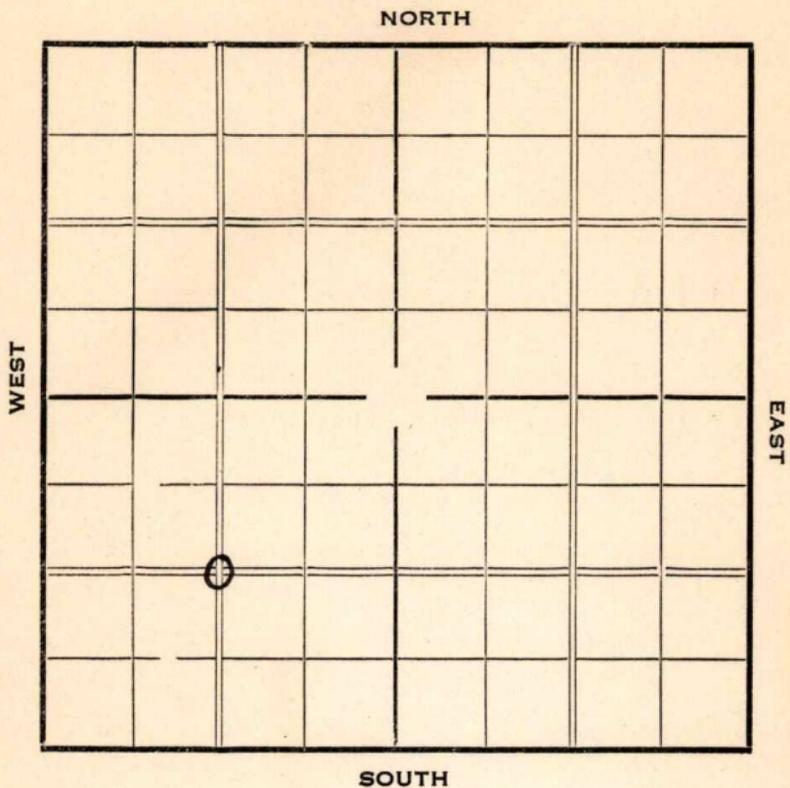

1937

4/28

Viola 4017'.

Simp. 4098'.

Wilcox 4109'.

P.B. 4035'.

Pot. 52,900,000 gas.

COMPLETED

Map No. 5447 Sec. 30 Twp. 27 R. 10W.

Well No. Interurban

Spelly Oil Company

Contractor

SECTION PLAT

_____ Ft. from N. Line

1320 Ft. from S. Line

_____ Ft. from E. Line

1820 Ft. from W. Line

FIRST REPORT

Location ✓

Rig up _____

Drilling and Remarks:

RECORD

Cased _____ in., _____ ft.

Sand _____

Gas _____

Oil _____

Total Depth _____

PRODUCTION

1st 24 hrs. Nat. _____

1st 24 hrs. after shot _____

Gas _____ Cu. Ft.

Dry Hole _____

Abandoned _____

Date

JAN 20 1937 ₁₉

S. J. LEWIS Scout

Map No. 54 Sec. 30 Twp. 27 R. 10W

Well No. 3 Interurban

Skelly Company

Contractor

SECTION PLAT

_____ Ft. from N. Line

1320 Ft. from S. Line

_____ Ft. from E. Line

1320 Ft. from W. Line

CORRECTION

Location _____

Rig up _____

Drilling and Remarks:

*Reported as
No. 1*

RECORD

Cased _____ in., _____ ft.

Sand _____

Gas _____

Oil _____

Total Depth _____

PRODUCTION

1st 24 hrs. Nat. _____

1st 24 hrs. after shot _____

Gas _____ Cu. Ft.

Dry Hole _____

Abandoned _____

Date

FEB 3 1937 19

S. J. LEWIS Scout

Kingman **KANSAS**

Map No. 54 Sec. 30 Twp. 27 R. 10^w

Well No. 3-Interurban

Skelly Company

Contractor

COMPLETED

SECTION PLAT

_____ Ft. from N. Line

1320 Ft. from S. Line

_____ Ft. from E. Line

1320 Ft. from W. Line

Location _____

Rig up _____

Drilling and Remarks:

P.B. 4035

POT - 52,900,000
gas

RECORD

Cased _____ in., _____ ft.

Sand 1012 - 4017
5117 - 4098

Gas Wilcox - 4109

Oil _____

Total Depth 4154

PRODUCTION

1st 24 hrs. Nat. _____

1st 24 hrs. after shot _____

Gas _____ Cu. Ft.

Dry Hole _____

Abandoned _____

Date

APR 28 1937

19

H. D. Hatfield Scout