


KANSAS

Kingman

Section 10 Township 27 Range 10-W

Well No. #1 Shepherd

Company Bunte Bros. Inc.

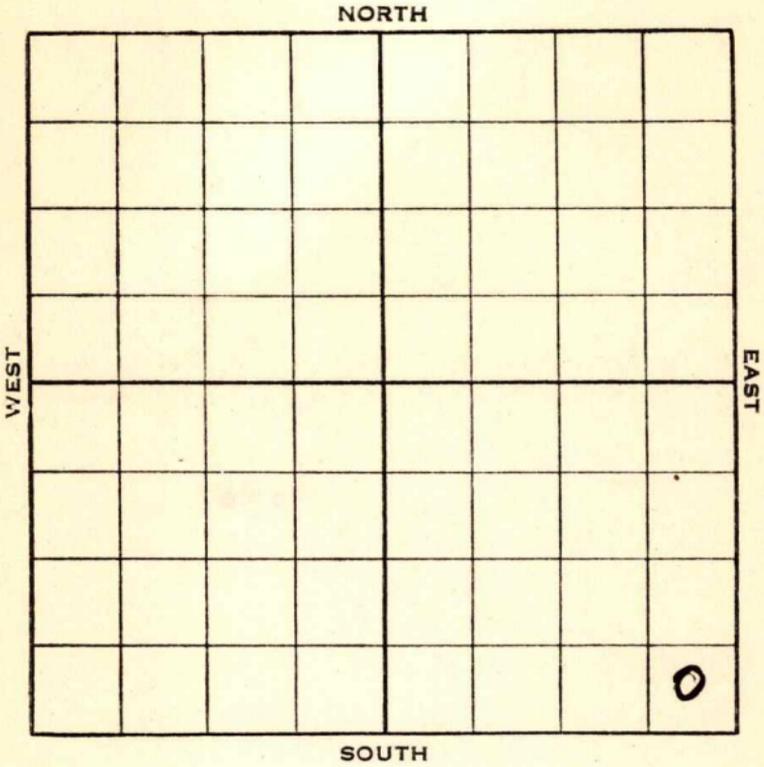

KANSAS

Kingman

Sec. 10 Twp. 27 R. 10-W

Well No. #1 Shepherd Farm


Bunte Bros. Inc. Company

SE/c
Ft. from N. Line

330 Ft. from S. Line

330 Ft. from E. Line

Ft. from W. Line

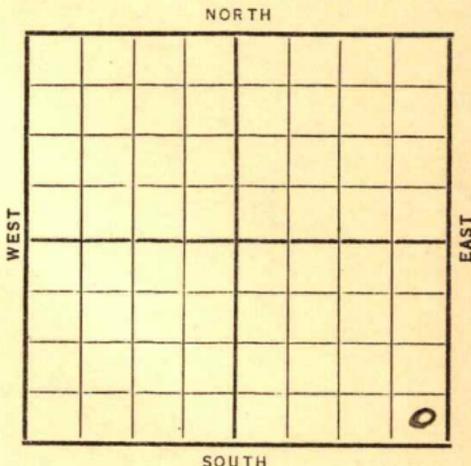

Shell Farmout

Date	Elev. 1769	REPORT
1938		
6/29		Cellar & Pits
7/8		R U R
7/15		13" - 241'. Dlg. 525'.
7/22		Fort Riley 1715'. Topeka 2978'. Lans. 34488. Dlg. 3534'. No shows.
7/29		S. O. in cuttings 3570-71'. S. O. 3581-83'. Miss. 4028'. S. O. in samples. Kinderhook 4090'. Dlg. 4135'.
8/5		Viola 4305'. Simp. 4400'. Arb. 4488'. T.D. 4529'. No shows. S.D.O.
8/12		Plugging back.
8/19		7" - 4075'. WOO.
8/26		P. B. 4086'. 7" - 4030' (Corrected) Perf. 40 shots 3500-29'. Swab 1/2 bbls. oil & 1/2 bbls. water per hr. C. O.

OVER

8/31--**Arbuckle 4488** T.D. 4529 No show
P.B. to 3609 to test Lansing
Perforated 40 shots 3566-80
Intended to set plug at 3580 but plug
hung at 3520 Acidized 1000 gallons
Acid went into Pongano~~X~~ie sand just
above Lansing
Hole filled up 100 feet oil per hour
Swabbing 4 bbls. oil per hour Does not
lower fluid (Tel)

9/9 " " " " " "

9/16 Shut down.

9/23 " "

9/30 " "

10/7 " "

10/14 " "

10/21 " "

10/28 " "

11/4 Pump 27 oil & 22 wtr. in 6 hrs.

11/12 Testing.

11/18 1600 acid. Pump 81 oil & 25
water in 20 hrs.

11/25 Testing.

12/2 "

12/9 "

12/13 **Lans. 3535'.**
Miss. 4028'.
Kind. 4090'.
Viola 4305'.
Simp. 4400'.

Arb. 4488-4529' T. D.
P. B. 3609'. 2000 acid.
Est. 50 oil & 50 water.

COMPLETED

Map No. 54 Sec. 10 Twp. 27 R. 10W


Well No. 1 Shepherd

Bunte Bros. Inc. Company

Contractor

FIRST REPORT
SE/C

SECTION PLAT

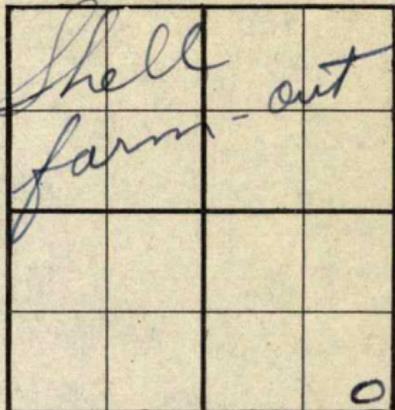

_____ Ft. from N. Line

330 Ft. from S. Line

330 Ft. from E. Line

_____ Ft. from W. Line

Location _____

Rig up _____

Drilling and Remarks:

Cellar & Pits

RECORD

Cased _____ in., _____ ft.

Sand _____

Gas _____

Oil _____

Total Depth _____

PRODUCTION

1st 24 hrs. Nat. _____

1st 24 hrs. after shot _____

Gas _____ Cu. Ft.

Dry Hole _____

Abandoned _____

Date

JUN 29 1938 19 _____ H. D. Hatfield Scout

Map No. 54 Sec. 10 Twp. 27 R. 10W

Well No. 1 Sheppard

Bunte Bros. Inc. Company

Contractor

COMPLETED

SECTION PLAT

SE/C

 Ft. from N. Line

330 Ft. from S. Line

330 Ft. from E. Line

 Ft. from W. Line

			0

Location

Rig up

Drilling and Remarks:

*LANS 3535
MISS 4028
Kind. 4090
Viola 4305
Simp 4400
Arb 4488-4529 TD,
P.B. 3609 2600 Acid
EST 50 oil
50 wtr*

RECORD

Cased in., ft.

Sand

Gas

Oil

Total Depth

PRODUCTION

1st 24 hrs. Nat.

1st 24 hrs. after shot

Gas Cu. Ft.

Dry Hole

Abandoned

Date

DEC 13 1938

19

H. D. Hatfield

Scout