

O.W.W.O. Kingman P B

KANSAS

Sec. 13 Twp. 27 R. 10W

Well No. #1 Freeland Farm

Anderson & Prichard Company

B & B Drlg. - Contr. Contractor
Dresden Pool


Ft. from N. Line

330' Ft. from S. Line

Ft. from E. Line

330' Ft. from W. Line

SW SW SE

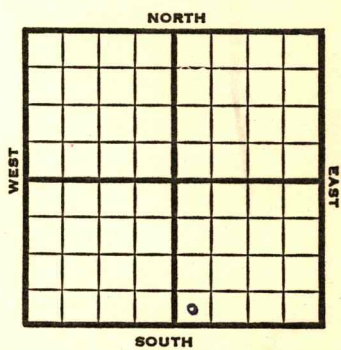

1951 Elev. 1720' REPORT

6/13 Spud 6-10-51
8" @ 311
WOC

8/8 Spud 6-10-51 Oil well TD 4267'
 8" @ 311' Anhy 620' Br. lime 3460'
 Lans. 3468'
 DST 3656-65 open 1 hr. rec 20' SOCM
 DST 3797-3815 open 1 hr. rec 30' GCM
 & SSO
 Miss 3989'
 DST 3993-4013 open 1/2 hr. rec 90' GCM
 Kh. 4078' Viola 4264' TD 4267'
 5" @ 4265' DD 4270' 500 A
 1 1/2 BFPH 1/3 water DD 4272'
 2000 A S/15 BO 7 BW 18 hr.
 500 A S/25 BO 50 BWPD SP 4065
 50/4005-10 61/4003-05
 9/4010-13 6/4013-15 9/4000-03
 SSO 6/3998-4000 78/3987-4000
 Hydrofrac S/60 BF F/69 BO
 35 BWPD
 Comp. F/19 BOPD 50% water

COMPLETED

OVER

1951
9/12

O.W.W.O.

Miss 3989' Viola 4264' 5" @ 4265'
TD 4272' PB 4065' Was prod. from
Miss.
DP to 4272' S/30 BO 41 BW 17 hr.
S/27 BOPD 54 BWPD S/24½ BO 41 BW
21 hr.
POP

10/3

Oil well TD 4272' Miss 3989'
Viola 4264' 5" @ 4265' TD 4272'
PB 4065' DP to 4272' S/30 BO
41 BW 17 hr. S/27 BOPD 54 BW
S/24½ BO 41 BW 21 hr.
Comp. 35 BOPD 34% water.

COMPLETED

1953

O.W.P.B.

10/21

Lans 3468' Miss. 3989' H. 4078
Viola 4264 OTD 4272 5" @ 4265
SP 3840 24/3806-12 1 GWPH 3 hrs.
500 A S/37 BO 34 BW 21 hrs.
Dec. to 1¼ BO 7 BWPH
P/16 BO 5 BWPD

10/28

Oil well TD 4272 Lans 3468
Miss 3989 Kh. 4078' Viola 4264
OTD 4272 5" @ 4265 SP 3840
24/3806-12 1 GWPH 3 hr.
500 A S/37 BO 34 BW 21 hrs.
Dec. to 1¼ BO 7 BWPH
Comp. 16 BOPD 5 BW

COMPLETED

County Kingman State Kansas

Sec. 13 (Bk.) 27 (Sur.) 10W Map No.

Operator Anderson & Prichard

Well No. 1 Farm Freeland

Elev. _____ Location SW SW SE

330 Ft. From 5 Line SE

330 Ft. From W Line Quarter

lst. Report JUN 13 1951

Completion _____

Remarks _____

B&B Drlg. - Contracting

Spudding Date 6-10-51

Drlg. Data _____

8" @ 311 WOC Dresden Pool


County Kingman State Kansas

Sec. 13 (Blk. 27) (Sur. 10W) (Twp. Rge.) Map No.

Operator Anderson & Prichard

Well No. 1 Farm Freeland

Elev. 1720 Location SW SW SE

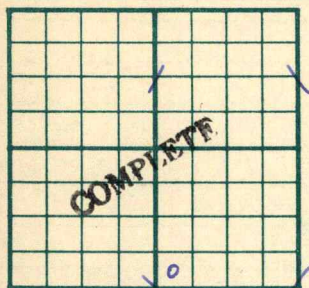

330 Ft. From S Line SE
330 Ft. From W Line Quarter

1st. Report

Completion AUG 8 1951

Remarks Dresden Pool

B & B Drlg. - Contr.

Spudding Date 6-10-51

Drlg. Data Oil well TD 4267

8" @ 311 Anhy 620 Br. lime 3460

Lans. 3468 DST 3656-65 open 1 hr.

Rec. 20' socm DST 3797-3815 open 1 hr.

Rec. 30' gcm & SSO Miss. 3989

DST 3993-4013 open 1/2 hr. Rec. 90' gcm

Kh. 4078 Viola 4264 TD 4267 5" @ 4265

DD 4270 500 A 1 1/2 bfph 1/3 water

DD 4272 2000 A S/ 15 bo 7 bw 18 hr.

500 A S. 25 bo 50 bwpd SP 4065

50/ 4005-10 61/ 4003-05 9/ 4010-13

6/ 4013-15 9/ 4000-03 SSO 6/ 3998-4000

78/ 3987-4000 Hydrofrac S/ 60 bf

F/ 69 bo 35 bwpd Comp. F/ 19 bopd 50% w

J. E. TYRA

