


Section 13 Township 27 Range 10W

Well No. #2 McMichael

Company Lion Oil

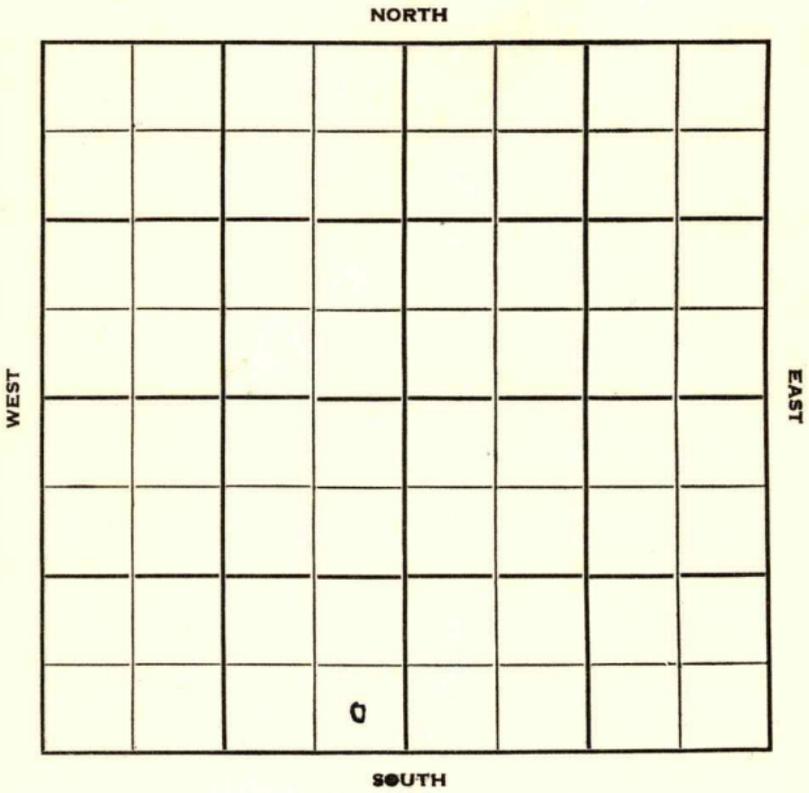

Kingman

KANSAS

Sec. 13 Twp. 27 R. 10W

Well No. #2 McMichael Farm

Lion Oil Company

Rine Drlg. - Contr. Contractor


Wildcat

 Ft. from N. Line

330' Ft. from S. Line

330' Ft. from E. Line

 Ft. from W. Line

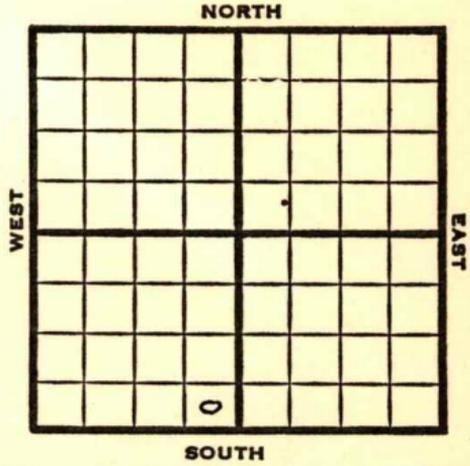

SE SE SW

1951

Elev. 1727' REPORT

4/25 Spud 4-21-51

8" @292

Drlg. 1820'

6/13 Spud 4-21-51

Oil Well TD 4470 8" @ 292'

Br Line 3462 Lans. 3467

DST 3813-25 opn 20 min. Rec. 1600'

gas 50' hocm & free oil

Miss 4000 DST 4000-15 opn 1/2 hr

Rec. 35' mud **Kh 4049 Viola 4265**

DST 4265-70 Rec. 65' ocm 1900' gas

DST 4266-75 opn 45 min. Rec. 140'

oil 70' ocm DST 4275-85 opn 1/2 hr.

Rec. 25' mud **Simp. 4356 Sand 4363**

DST 4350-70 opn 1/2 hr Rec. 390' wtr

& SSO **Arb. 4455-70** 5" @ 4350

CO to 4318 24/4270-78 S/3 boph

500 A S/100 bo S/33 boph

P/160 bf 14 hr. 5% w


P 175 bf 15 hr. 10% wtr.

P 200 bfpd 10% wtr

Comp. 432 bopd 5% wtr.

COMPLETED

County Kingman State Kansas
 Sec. 13 (Bik. 27 (Sur. 10W Map No.
 Twp.) Rge.)
 Operator Lion Oil
 Well No. 2 Farm McMichael
 Elev. 1727 Location SE SE SW

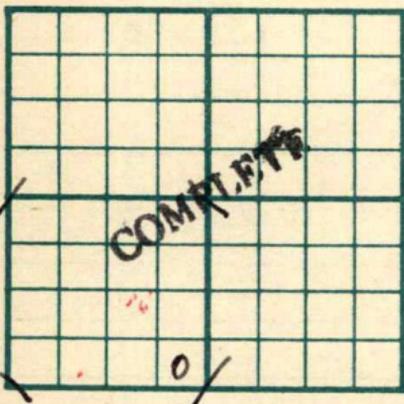

330 Ft. From S Line SW
330 Ft. From E Line Quarter
 Ist. Report _____
 Completion JUN 13 1951
 Remarks Wildcat
Rine Drlg. - Contr.
 Spudding Date 4-21-51

Drlg. Data Oil well TD 4470

8" @ 292 Br. lime 3462

Lans. 3467 DST 3813-25 open 20min.

Rec. 1600' gas 50' hocm & free oil

Miss. 4000 DST 4000-15 open 1/2 hr.

Rec. 35' mud Kh. 4049 Viola 4265

Dst 4265-70 Rec. 65' ocm 1900' gas

DST 4266-75 open 45 min. Rec. 140'

oil 70' ocm DST 4275-85

open 1/2 hr. Rec. 25' mud Simp. 4356

Sand 4363 DST 4350-70 open 1/2 hr.

Rec. 390' water & SSO Arb. 4455-70

5" @ 4350 CO to 4318 24/ 4270-78

S/ 3 boph 500 A S/ 100 bo

S/ 33 boph P/ 160 bf 14 hr. 5% w

J. E. TYRA

Drig. Data

P/ 175 bf 15 hr. 10% water

P/ 200 bfpd 10% wate

Comp. 432 bopd 5% water

APR 18 1953

Scout Cards
Land Small Map
Land Wall Map
Tracings
France Map
Pierce Map
Misc.