



Sec. 13 Twp. 27 R. 10 W ✓

Well No. # 6 McMichael Farm

Lion Oil Company

Contractor

Dresden


Ft. from N. Line

330 Ft. from S. Line

Ft. from E. Line

990 Ft. from W. Line

SE SW SW

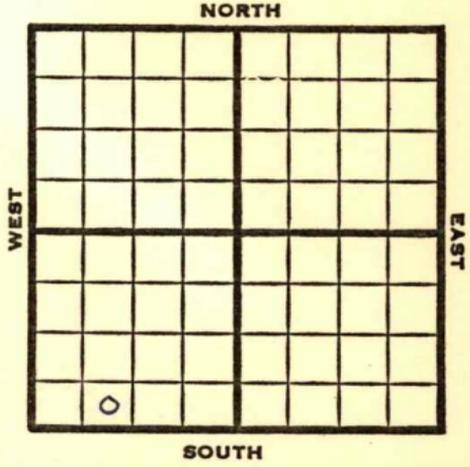

1951 **Elv. 1744'** REPORT

6/20 **Location**

8/1 Spud 6-21-51  
 Oil Well TD 4283  
 9" @ 294  
 Br Lime 3490      Lans. 3500  
 Miss 4022      Viola 4280-82  
 5" @ 4279      TD 4283  
 500 A      F/30 bo 1/2 hr  
 Comp. BHB 3000 bopd

**COMPLETED**



