

Section 13 Township 27 Range 10W

Well No. #7 McMichael

Company Lion Oil

NORTH

0							

SOUTH

WEST

EAST

Kingman

KANSAS

Sec. 13 Twp. 27 R. 10W

Well No. #7 McMichael Farm

Lion Oil Company

Dresden Pool Contractor


Ft. from N. Line

990' Ft. from S. Line

Ft. from E. Line

330' Ft. from W. Line

NW SW SW

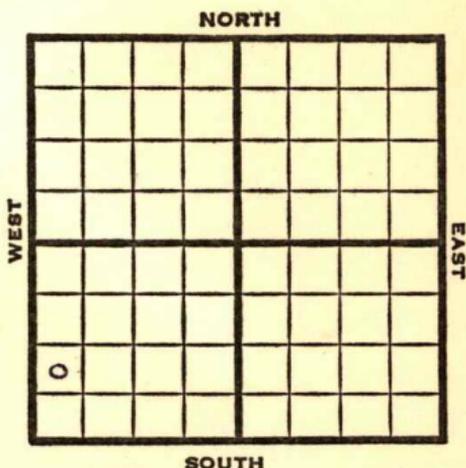

1951

Elev. 1755' REPORT

6/20 Location

8/8 Spud 6-28-51

Oil well TD 4294' 9" @ 305

Br. line 3502' Lans. 3515'

Miss. 4022' Viola 4291-93'

5" @ 4292' TD 4294' 750 A

F/43 BOPH

Comp. BHB 1968 BOPD

COMPLETED

