


O.W.W.O.

Section 13 Township 27 Range 10W

Well No. 1 McMichael

Company Lion Oil

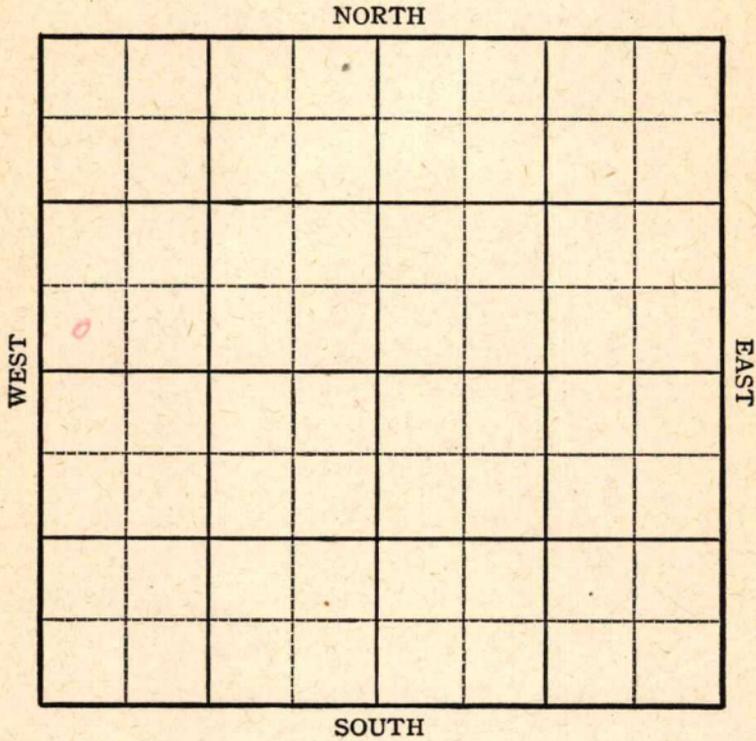

KANSAS

Kingman ✓

Sec. 13 Twp. 27 R. 10-W

Well No. #1 McMichael Farm

Lion Oil Company


Rine Drlg. Co. - Contr. NORTH

Ft. from N. Line

330 Ft. from S. Line

Ft. from E. Line

330 Ft. from W. Line

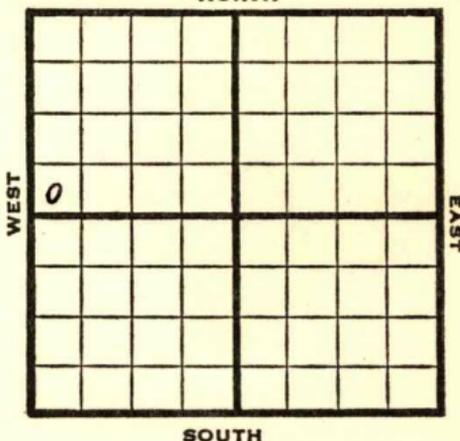

SW NW

REPORT

1945 **Elev. 1750**

9/12 Surface hole.

9/19 8" @ 315
Drlg. 2487

9/26 **Lans 3506**
Drlg. 3780

10/3 **Miss. 4018**
Kind. 4067
Viola 4284
Simp Sd 4381
Arb. 4467

TD 4500 no shows.

10/10 **Arb. 4467**
TD 4500'

ABANDONED

O.W.W.O.

1951
7/11 **Lans. 3506**

Miss 4018
Viola 4284
Simp 4367

Arb. 4467-4500 TD was D&A

CO @ 1600

8/22 Oil Well TD 4306

Lans. 3506 **Miss 4018**
Viola 4284 **Simp 4377**
Arb. 4467-4500 OTD

CO to 4440 5" @ 4350

DC 4306

24/4287-91 S/1 boph 750 A

S/30 boph Comp. 328 bopd 3% wtr.

COMPLETED

KANSAS
Kansas

Pool Name

Wildcat

Map No. 54

Sec. 13

Twp. 27

R. 10W

Well No. 1

McMichael

Lion Oil

Company

FIRST REPORT

Contractor

SW NW

SECTION PLAT

_____ Ft. from N. Line


330

Ft. from S. Line

_____ Ft. from E. Line

330

Ft. from W. Line

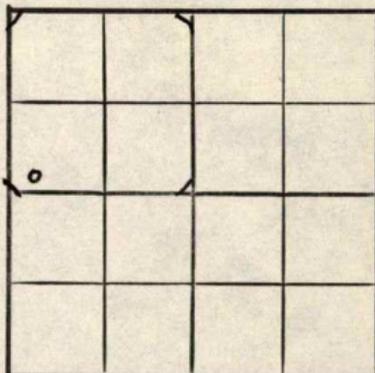

Kingman County

Location _____

Rig up _____

Drilling and Remarks:

surface hole

RECORD

Cased _____ in., _____ ft.

Sand _____

Gas _____

Oil _____

Total Depth _____

PRODUCTION

1st 24 hrs. Nat. _____

1st 24 hrs. after shot _____

Gas _____ Cu. Ft.

Dry Hole _____

Abandoned _____

Date

SEP 12 1945

19

S. J. LEWIS

Scout

