


Section 13 Township 27 Range 10W

Well No. #5 McMichael

Company Lion Oil

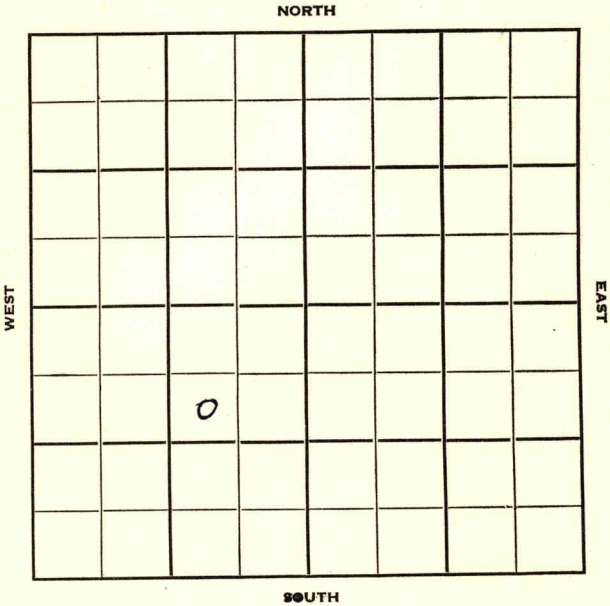

Kingman

KANSAS

Sec. 13 Twp. 27 R. 10 W

Well No. # 5 McMichael Farm

Lion Oil

Company

Contractor


990 Ft. from N. Line

Ft. from S. Line

990 Ft. from E. Line

Ft. from W. Line

SW NE SW

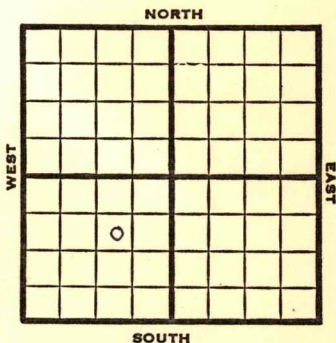

1951

Elev. 1734 REPORT

6/20

Spud 6-16-51
" @ 290'
Drlg. 1970'

8/15

Spud 6-16-51
Oil Well TD 4279
9" @ 290
Br Lime 3471 Lans. 3480
Miss 4004
DST 4005-30 opn 1 hr Rec. 95' socm
1170' gas Viola dol. 4273
5" @ 4275 TD 4279
S/1½ boph 1000 A F/20 boph
Comp. F/407 bopd

COMPLETED

Operator Lion Oil

Well No. **5** Farm **McMichael**

Elev.	Location
SW NE SW	

FIRST REPORT

990 Ft. From **N** Line **SW**
990 Ft. From **E** Line Quarter

1st. Report JUN 20 1951

Completion

Remarks

Spudding Date **6-16-51**

Drlg. Data

" @ 290! Drlg. 1970

J. E. TYRA

Operator Lion Oil

Well No. 5 Farm McMichael

Elev.	1734	Location	SW NE SW
-------	------	----------	----------

COMPLETE

0

990 Ft. From N Line SW

990 Ft. From E Line Quarter

1st. Report

Completion AUG 15 1951

Remarks

Spudding Date 6-16-51

Drlg. Data Oil well TD 4279

9" @ 290 Br. lime 3471 Lans. 3480

Miss. 4004 DST 4005-30 open 1 hr.

Rec. 95' socm 1170' gas Viola dol. 4273

5" @ 4275 TD 4279 S/ $1\frac{1}{2}$ bophl 1000 A

F/ 20 boph Comp. F/ 407 bopd

J. E. TYRA