

Section 13 Township 27 Range 10 WWell No. # 8 McMichaelCompany Lion Oil

NORTH

WEST

0							

EAST

SOUTH

Kingman

KANSAS

Sec. 13 Twp. 27 R. 10 W ✓

Well No. # 8 McMichael Farm

Lion Oil Company

Contractor

Dresden Pool


330 Ft. from N. Line

Ft. from S. Line

Ft. from E. Line

330 Ft. from W. Line

NW NW SW

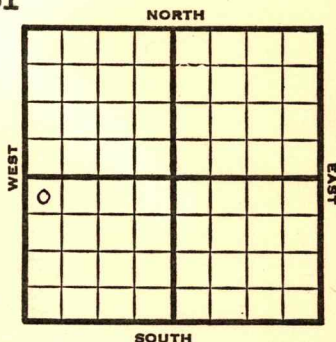

1951

Elev. 1755'

REPORT

6/27
8/8

Location

Spud 6-28-51

Oil well TD 4288' 9" @ 295'

Br. lime 3499' Lans. 3508'

Miss. 4018' Viola 4283'

5" @ 4284' TD 4288' 500 A

F/31 BOPH

Comp. BHB 3000 BOPD

COMPLETED

County Kingman State Kansas

Sec. 13 (Blk. Twp.) 27 (Sur. Rge.) 10W Map No.

Operator Lion Oil

Well No. 8 Farm McMichael

Elev.	1755	Location	NW NW SW
-------	------	----------	----------

330 Ft. From N Line SW

330 Ft. From W Line Quarter

1st. Report

Completion AUG 8 1951

Remarks	Dresden Pool
---------	--------------

Spudding Date 6-28-51

Drlg. Data Oil well TD 4288

9" @ 295 Br. lime 3499 Lans. 3508

Miss. 4018 Viola 4283 5" @ 4284

TD 4288 500 A F/ 31 boph

Comp. BHB 3000 bopd

J. E. TYRA

Kingman

Kansas

13

(Blk.)
(Twp.)

27

(Sur.)
(Rge.)

LOW

Map No.

Operator

Lion Oil

Well No.

8

Farm

McMichael

Elev.

Location

NW NW SW

[illegible]

330

Ft. From

IN

Line

SW

330

Ft. From

10

Line

Quarter

1st. Report

JUN

25

1951

Completion

Remarks

Spudding Date

Drlg. Data

Dresden Pool

Location

J. E. TYRA