
FORM 51 25M 8-50 WESTERN Kingman KANSAS

Section 13 Township 27 Range 10 W

Well No. # 9 McMichael

Company Lion Oil

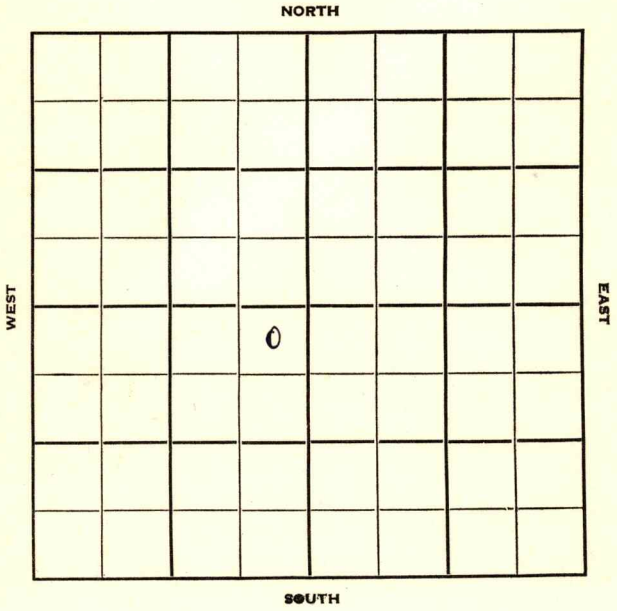

FORM 252-B
10M 11-50 PETROL

Kingman KANSAS

Sec. 13 Twp. 27 R. 10 W

Well No. # 9 McMichael Farm

Lion Oil Company

Contractor

Dresden Pool


330 Ft. from N. Line

Ft. from S. Line

330 Ft. from E. Line

Ft. from W. Line

NE NE SW

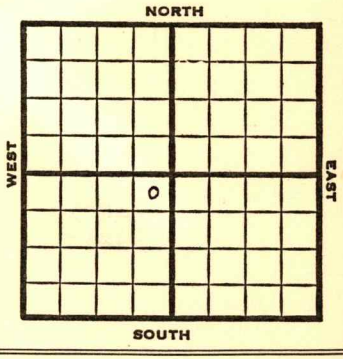

1951	Elev. 1740' REPORT
6/27	Location
8/22	Spud 7-4-51 Oil Well TD 4279 9" @ 190 Br Lime 3477 Lans. 3486 Miss 4008 Viola 4273 TD 4277 5" @ 4274 DD 4279 S/2 boph 750 A S/5 boph Comp. F/134 bopd COMPLETED

FORM 275 FOR SALE BY KANSAS BLUE PRINT CO.

County Kingman State Kansas

Sec. 13 (Blk. / Twp.) 27 (Sur. / Rge.) 10W Map No.

Operator Lion Oil

Well No. 9 Farm McMichael

Elev. Location NE NE SW



330 Ft. From N Line SW

330 Ft. From E Line Quarter

1st. Report JUN 27 1951

Completion

Remarks

Spudding Date

Drlg. Data Dresden Pool

Location

J. E. TYRA

FORM 275 FOR SALE BY KANSAS BLUE PRINT CO.


County Kingman State Kansas

Sec. 13 (Blk. / Twp.) 27 (Sur. / Rge.) 10W Map No.

Operator Lion Oil

Well No. 9 Farm McMichael

Elev. 1740 Location NE NE SW

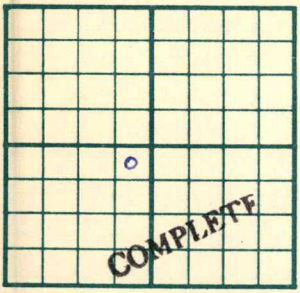

330 Ft. From N Line SW

330 Ft. From E Line Quarter

1st. Report

Completion AUG 2 2 1951

Remarks Dresden Pool

Spudding Date 7-4-51

Drlg. Data Oil well TD 4279

9" @ 190 Br. lime 3477 Lans. 3486

Miss. 4008 Viola 4273 TD 4277 5" @4274

DD 4279 S/ 2 boph 750 A S/ 5 boph

Comp. F/ 134 bopd

J. E. TYRA