


Section 13 Township 27 Range 10W

Well No. 11 McMichael

Company Lion Oil

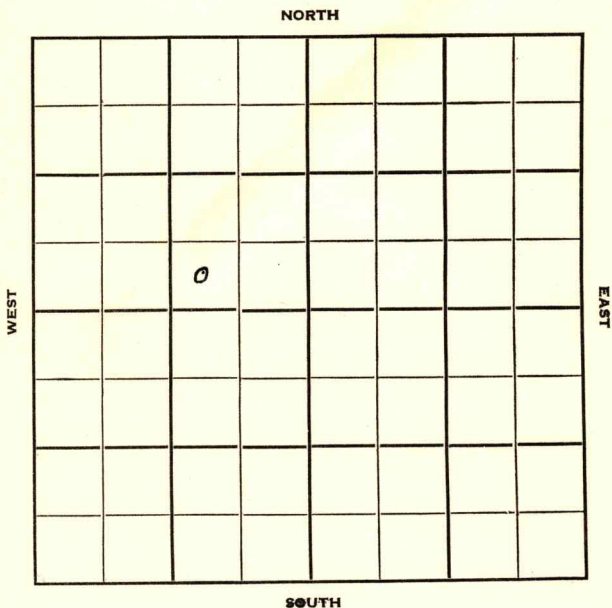

Kingman

KANSAS

Sec. 13 Twp. 27 R. 10

Well No. #11 McMichael Farm

Lion Oil Company

Rine Drlg. - Contr. Contractor

Dresden Pool


Ft. from N. Line

330' Ft. from S. Line

990' Ft. from E. Line

Ft. from W. Line

SW SE NW

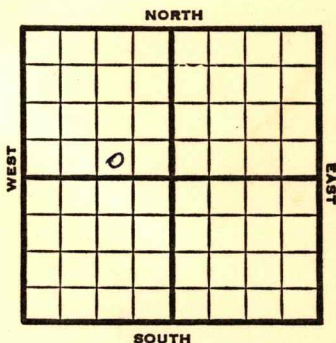

1951

Elev. 1749' REPORT

7/18

Location

8/29

Spud 7-22-51 Oil well TD 4280'
 8" @ 300 Br. line 3484' Lans 3494'
 Miss. 4022' Viola 4274-76'
 5" @ 4275 TD 4280' B/1/2 BOPH
 1000 A S/24 BOPH
 Comp. phy. pot. 328 BOPD 3% water

COMPLETED

County Kingman State Kansas

Sec. 13 (Blk.) 27 (Sur.) 10W Map No.

Operator Lion Oil

Well No. 11 Farm McMichael

Elev. 1749 Location SW SE NW

330 Ft. From S Line NW
990 Ft. From E Line Quarter

1st. Report

Completion AUG 29 1951

Remarks Dresden Pool

Rine Drlg. - Contr.

Spudding Date 7-22-51

COMPLETE

Drlg. Data Oil well TD 4280

8" @ 300 Br. lime 3484 Lans. 3494

Miss. 4022 Viola 4274-76 5" @ 4275

TD 4280 B/ 1/2 boph 1000 A S/ 24 boph

Comp. phy. pot. 328 bopd 3% water

J. E. TYRA