


Section 14 Township 27 Range 10W

Well No. #6 Bick

Company Lion Oil

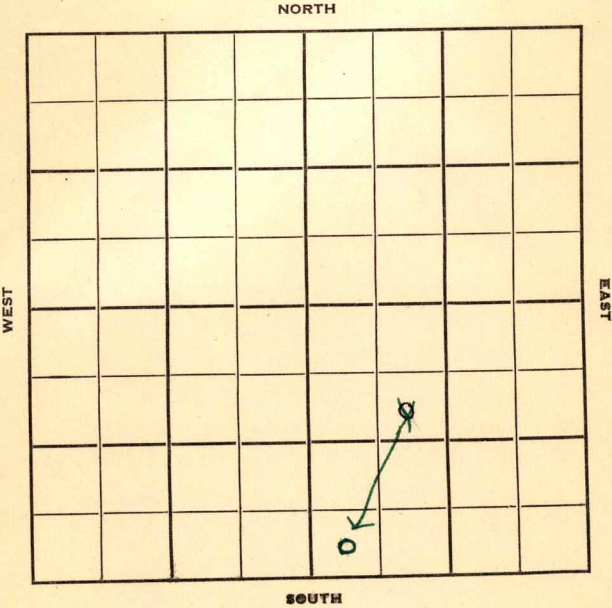

Kingman **KANSAS**

Sec. 14 Twp. 27 R. 10W

Well No. #6 Bick Farm

Lion Oil Company

Dresden Pool Contractor


-990+ Ft. from N. Line

330 Ft. from S. Line

990 Ft. from E. Line

330 Ft. from W. Line

SW SW SE
~~SE NW SE~~

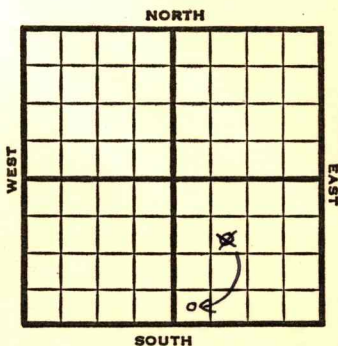

1951

Elev. 1724' REPORT

8/15

Location

10/17

Spud 9-19-51

D&A TD 4268

9" @ 270

Br. lime 3481

Miss. 3997

Viola 4266-68

Kh. 4074

Lans. 3493

TD 4268 5" @ 4267 500 A

S/ 50 BWPH PB 4055

72/ 3999-4023 wtr. 24/ 3948-56

24/ 3908-16 SP 3860 22/ 3842-50

1000 A S/ 1 BWPH SSO 23/ 3819-27

wtr. SP 3812 46/ 3786-3802

1000 A S/ wtr. SP 3730 24/ 3704-12

wtr. SP 3690 22/ 3670-78 wtr.

46/ 3621-37 24/ 3588-96 wtr.

24/ 3566-74 wtr. SP 3560 24/ 3547-

55 1000 A S/ 34 BW 1 BO SP 3525

23/ 3508-16 S/ 5 BWPH SP 3502

12/ 3494-98 S/ 5 BWPH

D&A

ABANDONED

County Kingman State Kansas
 Sec. 14 (Blk.) 27 (Sur.) 10W Map No.
 Operator Lion Oil
 Well No. 6 Farm Bick
 Elev. _____ Location SE NW SE

FIRST REPORT

990 Ft. From N Line SE
990 Ft. From W Line Quarter

1st. Report AUG 15 1951

Completion _____

Remarks _____

Spudding Date _____

Drlg. Data _____

Dresden Pool

Location

J. E. TYRA

Map No. _____ Sec. 14 Twp. 27 R. 10WWell No. 6 Bick_____Lion Oil_____ Company_____**CORRECTION**_____ Contractor

SW SW SE

SECTION PLAT

		0	

_____Ft. from N. Line330 Ft. from S. Line_____Ft. from E. Line330 Ft. from W. LineKingman County

Location _____

Rig up _____

Drilling and Remarks:

Reported

SE NW SE

RECORD

Cased _____ in., _____ ft.

Sand _____

Gas _____

Oil _____

Total Depth _____

PRODUCTION

1st 24 hrs. Nat. _____

1st 24 hrs. after shot _____

Gas _____ Cu. Ft.

Dry Hole _____

Abandoned _____

Date

SEP 10 1951 19J. E. TVRA Scout

County Kingman State Kansas
 Sec. 14 (Blk. 27) (Sur. 10W) Map No.
 Operator Lion Oil
 Well No. 6 Farm Bick
 Elev. 1724 Location SW SW SE



330 Ft. From S Line SE
 330 Ft. From W Line Quarter

1st. Report

Completion OCT 17 1951

Remarks Dresden Pool

Spudding Date 9-19-51

Drlg. Data D & A TD 4268

9" @ 270 Br. lime 3481 Viola 4266-68

Lans. 3493 Miss. 3997 Kh. 4074

TD 4268 5" @ 4267 500 A S/ 50 bwph

PB 4055 72/ 3999-4023 water 24/ 3948-

56 24/ 3908-16 SP 3860 22/ 3842-50

1000 A S/ 1 bwph SS0 23/ 3819-27

water SP 3812 46/ 3786-3802 1000 A

S/ water SP 3730 24/ 3704-12 water

SP 3690 22/ 3670-78 water 46/ 3621-37

24/ 3588-96 water 24/ 3566-74 water

SP 3560 24/ 3547-55 1000 A S/ 34 bw 1 bo

SP 3525 23/ 3508-16 S/ 5 bwph SP 3502

12/ 3494-98 S/ 5 bwph

D & A

J. E. TYRA