


Section 14 Township 27 Range 10W

Well No. 2 Bick

Company Lion Oil

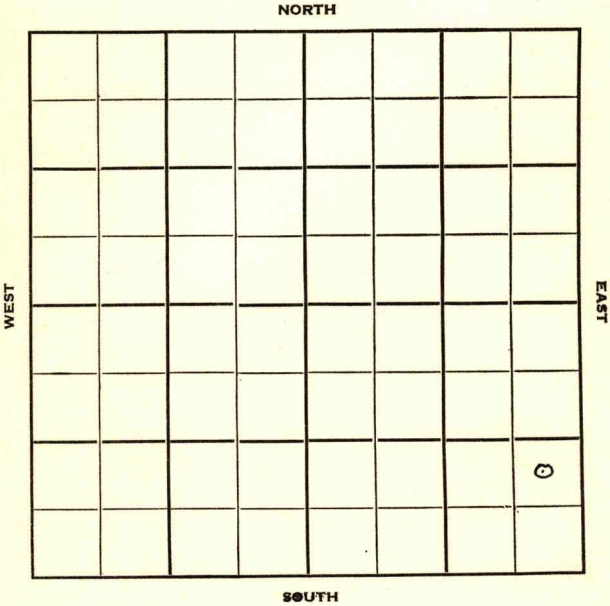

Kingman
27

KANSAS

Sec. 14 Twp. 27 R. 10W

Well No. #2 Bick Farm

Lion Oil Company

Rine Drlg. - Contr. Contractor

Dresden Pool


 Ft. from N. Line

990' Ft. from S. Line

330' Ft. from E. Line

 Ft. from W. Line

NE SE SE

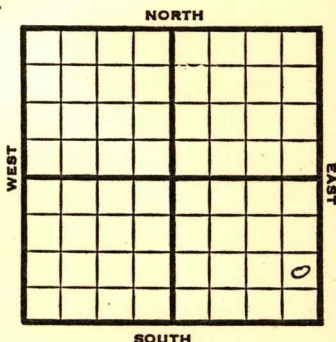

1951

Elev. 1744'

REPORT

7/18

Location

8/29

Spud 7-22-51

Oil well TD 4281' 8" @ 295'

Br. line 3491' Lans. 3504'

Miss. 4026' Viola 4272-80'

5" @ 4278' TD 4281' 1000 A

F/50 BOPH

Comp. BHB 2358 BOPD 10% water

COMPLETED

County **Kingman** State **Kansas**Sec. **14** (Bik. Twp.) **27** (Sur. Rge.) **10W** Map No.Operator **Lion Oil**Well No. **2** Farm **Block**Elev. Location **NE SE SE**

FIRST REPORT

990 Ft. From **S** Line **SE****330** Ft. From **E** Line Quarter1st. Report **JUL 18 1951**

Completion

Remarks


Rine Drlg. - Contr.

Spudding Date

Drlg. Data

Dresden Pool**Location****J. E. TYRA**

County Kingman State Kansas
 Sec. 14 (Blk.) 27 (Sur.) 10W Map No.
 Operator Lion Oil
 Well No. 2 Farm Bick
 Elev. 1744 Location NE SE SE

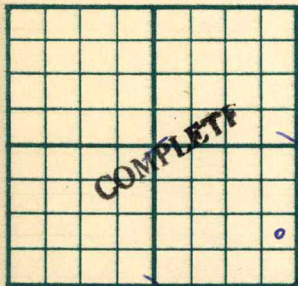

990 Ft. From S Line SE
330 Ft. From E Line Quarter

1st. Report

Completion AUG 29 1951

Remarks Dresden Pool

Rine Drlg. - Contr.

Spudding Date 7-22-51

Drlg. Data Oil well TD 4281
8" @ 295 Br. line 3491 Lans. 3504

Miss. 4026 Viola 4272-80 5" @ 4278

TD 4281 1000 A F/ 50 boph

Comp. BHB 2358 bopd 10% water

J. E. TYRA