


Section 14 Township 27 Range 10W

Well No. 1 Cannon

Company Lion Oil

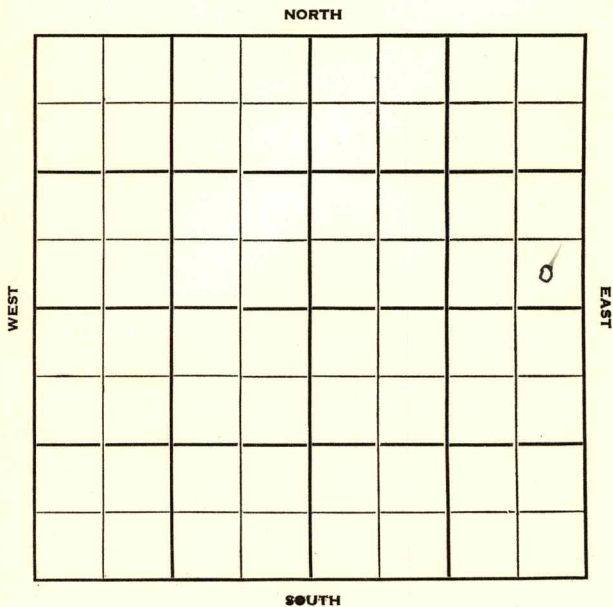

Kingman **KANSAS**

Sec. 14 Twp. 27 R. 10W ✓

Well No. #1 Cannon Farm

Lion Oil Company

Rine Drlg. - Contr. Contractor

Dresden Pool


 Ft. from N. Line

330' Ft. from S. Line

330' Ft. from E. Line

 Ft. from W. Line

SE SE NE

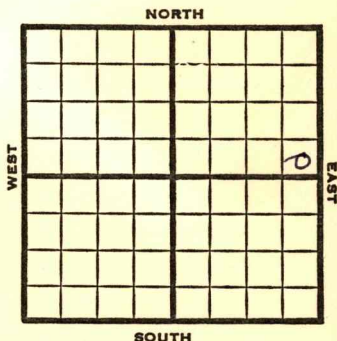

1951 **Elev. 1749** REPORT

8/1 Spud 7-26-51
8" @ 301
Drlg. 2900'

9/12 Spud 7-26-51
Oil Well TD 4287
8" @ 301
Br Line 3491 Lans. 3502
Miss 4023 Kh 4090
Viola 4284-86
5" @ 4285 TD 4287
B/1/2 boph 1000 A
S/25 bfph 15% wtr
Comp. 188 bopd 20% wtr.

COMPLETED

County Kingman State KansasSec. 14 (Blk.) 27 (Sur.) LOW Map No.Operator Lion OilWell No. 1 Farm CannonElev. 1749 Location SE SE NE

330 Ft. From S Line NE330 Ft. From E Line Quarter1st. Report AUG 1 1951

Completion

Remarks

Rine Drlg. - Contr.Spudding Date 7-26-51Drlg. Data Dresden Pool8" @ 301 drlg. 2900

J. E. TYRA

County Kingman State KansasSec. 14 (Blk.
Twp.) 27 (Sur.
Rge.) 10W Map No.Operator Lion OilWell No. 1 Farm CannonElev. 1749 Location SE SE NE

330 Ft. From S Line NE330 Ft. From E Line Quarter

1st. Report

Completion SEP 12 1951Remarks Dresden PoolRine Drlg. - Contr.Spudding Date 7-26-51Drlg. Data Oil well TD 42878" @ 301 Br. lime 3491 Lans. 3502Miss. 4023 KH. 4090 Viola 4284-865" @ 4285 TD 4287 B/ $\frac{1}{2}$ boph 1000 AS/ 25 bfph 15% waterComp. 198 bopd 20% water