


Section 14 Township 27 Range 10W

Well No. #3 Cannon

Company Lion Oil

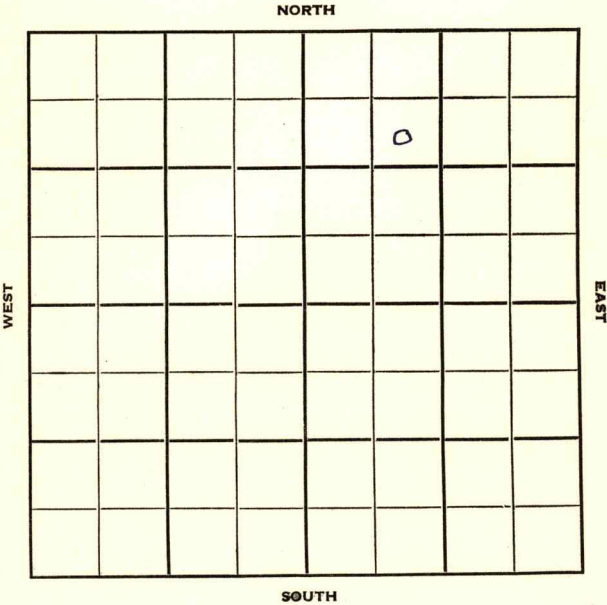

Kingman

KANSAS

Sec. 14 Twp. 27 R. 10W

Well No. #3 Cannon Farm

Lion Oil Company

Rine Drlg. -Contr. Contractor

Dresden Pool


990' Ft. from N. Line

 Ft. from S. Line

 Ft. from E. Line

990' Ft. from W. Line

SE NW NE

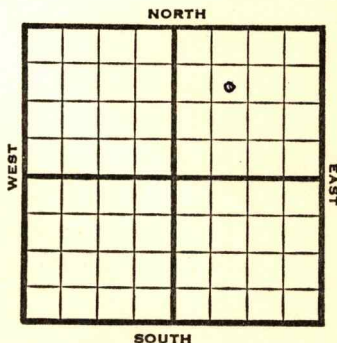

1951 **Elve. 1748'** REPORT

8/29 Spud 8-26-51
9" @ 308'
WOC

10/27 Spud 8-26-51
Oil Well
TD 4276
9" @ 308

Br. lime 3479

Kh. 4076

Ians. 3491

Viola 4274

Miss. 4015

TD 4276

5" @ 4275 CO to 4276 1000 A

S/ 10 BOPH 5 BW Comp. 217 BOPD

20% wtr.

COMPLETED

County

State Kansas

Sec.

14

(Blk.)
(Twp.)

27

(Sur.)
(Rge.)

LOW

Map No.

Operator

Lion Oil

Well No.

3

Farm

Cannon

Elev.

Location

SE NW NE

FIRST REPORT

990 Ft. From

N Line

NE

990 Ft. From

W Line

Quarter

1st. Report

AUG 29 1951

Completion

Remarks

Rine Drlg. - Contr.

Spudding Date

8-26-51

Drlg. Data

Dresden Pool

9" @ 308 WOC

J. E. TYRA

County Kingman State KansasSec. 14 (Blk.
Twp.) 27 (Sur.
Rge.) 10W Map No.Operator Lion OilWell No. 3 Farm CannonElev. 1748 Location SE NW NE

990 Ft. From N Line NE990 Ft. From W Line Quarter1st. ReportCompletion OCT 17 1951Remarks Dresden PoolRine Drlg. - Contr.Spudding Date 8-26-51Drlg. Data Oil well TD 42769" @ 308 Br. line 3479 Lans. 3491Miss. 4015 Kh. 4076 Viola 4274TD 4276 5" @ 4275 CO to 4276 1000 AS/ 10 boph 5 bw Comp. 217 bopd 20% water

J. E. TYRA