


Section 15 Township 27 Range 10 W

Well No. # 2 McCartney


Company B & R

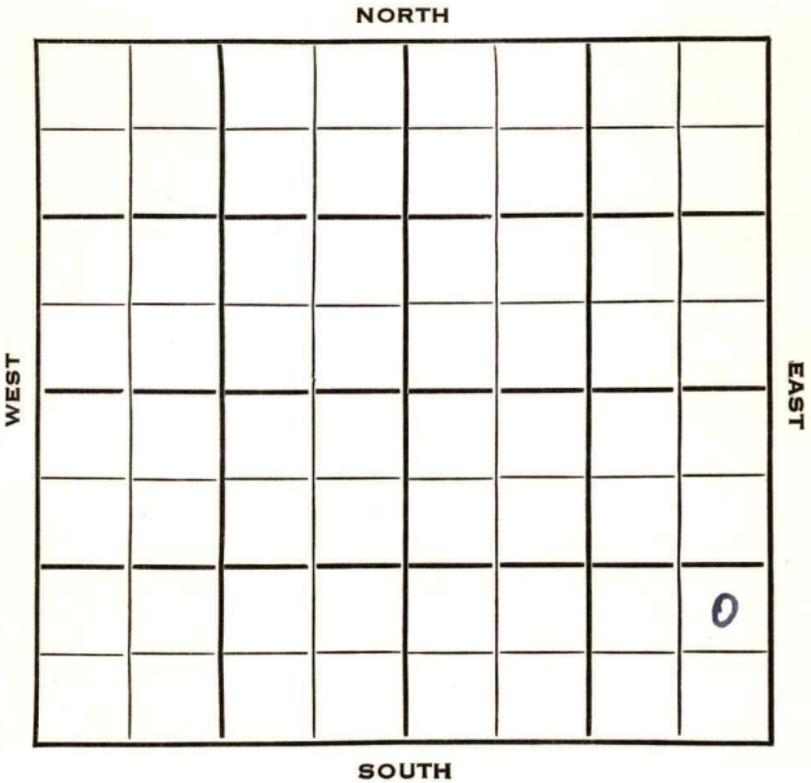

Kingman KANSAS

| | | |
|---------------|------|------|
| SEC. | TWP. | R. |
| 15 | 27 | 10 W |
| WELL NO. | | |
| # 2 McCartney | | FARM |
| COMPANY | | |
| B & R | | |
| CONTRACTOR | | |
| B & R | | |

_____ Ft. from N. Line
 990 _____ Ft. from S. Line
 330 _____ Ft. from E. Line
 _____ Ft. from W. Line

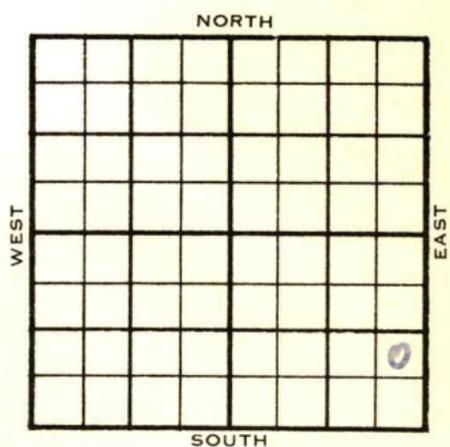

NE SE SE

| | ELEVATION | REPORT |
|--------------|---|--------|
| 1953 | 1762' | |
| 11/18 | RUR | |
| 1954 1/27 | Spud 11-17-53 Oil Well TD 4300' 8" @ 223' Miss 4033', Viola 4298', TD 4299' 5" @ 4298' DD 4300' FU 2000' oil 12 hrs. Comp. 86 bopd 20 bw | |

COMPLETED

