


Section 14 Township 27 Range 10 W

Well No. # 3 Sales

Company B & R Drlg.

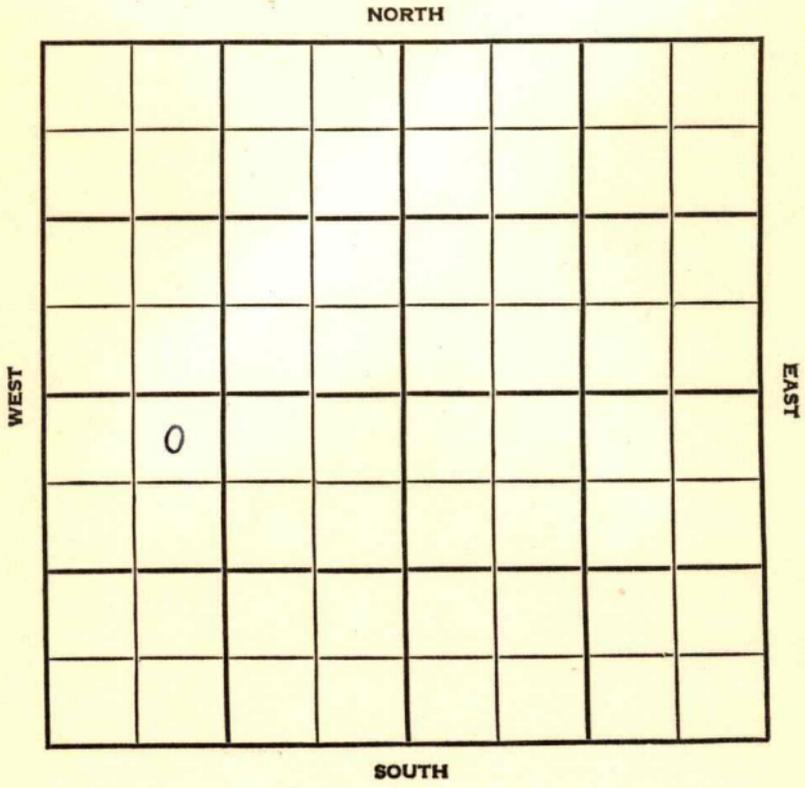

SEC.	TWP.	R.
14	27	10W

WELL NO. #3 Sales FARM

COMPANY B & R Drlg.

CONTRACTOR Co. Tools.

Dresden Pool

330	Ft. from N. Line	
_____	Ft. from S. Line	
_____	Ft. from E. Line	
990	Ft. from W. Line	

NE NW SW

1954	ELEVATION 1745'	REPORT
------	---------------------------	--------

10/13 Spud 10-8-54
8" @ 227'
Drlg. 2395'

12/15 Spud 10-8-54 Oil well TD 4282
8" @ 227 **Anhy 700 KC 3530**
Viola 4281 TD 4281 $\frac{1}{2}$ 5" @ 4281 $\frac{1}{2}$
DD 4282 S/1 $\frac{1}{2}$ BOPH 2 hr. P/60 BO
15 BWPD Comp. 60 BOPD 16 BW

COMPLETED

County Kingman State Kansas

Sec. 14 (Blk. 27 (Sur. 10W Map No. (Twp.))

Operator B & R Drlg.

Well No. 3 Farm Sales

Elev. 1745 Location NE NW SW

330 Ft. From N Line SW

990 Ft. From W Line Quarter

1st. Report

Completion DEC 15 1954

Remarks Dresden Pool

Co. tools

Spudding Date 10-8-54

Drlg. Data Oil well TD 4282¹

8" @ 227 Anhy 700 KC 3530

Viola 4281 TD 4281 $\frac{1}{2}$ 5" @ 4281 $\frac{1}{2}$

DD 4282 S/ 1 $\frac{1}{2}$ boph 2 hr. P/ 60 bo

15 bwpd Comp. 60 bopd 16 bw

FABEN GILSTRAP