


Kingman **KANSAS**

SECTION 14 TOWNSHIP 27 RANGE 10 W

WELL NO. #4 Sales

COMPANY Bennett & Roberts

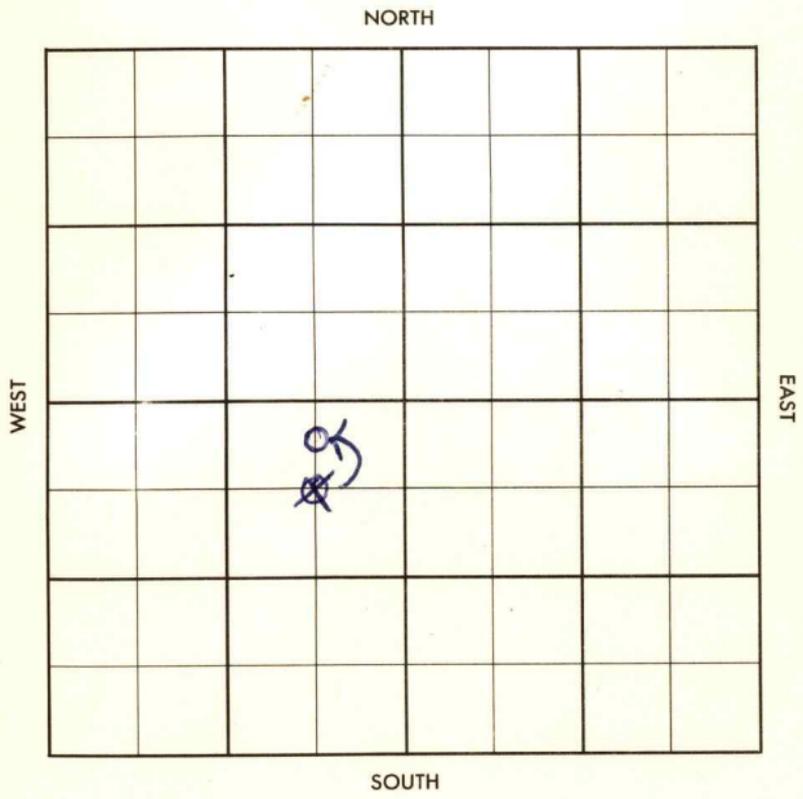

Kingman

KANSAS

SEC. 14	TWP. 27	R. 10W
------------	------------	-----------

WELL NO. #4 Sales FARM

COMPANY Bennett & Roberts

CONTRACTOR Co. tools


Driscen

_____ Ft. from N. Line

_____ Ft. from S. Line

_____ Ft. from E. Line

_____ Ft. from W. Line

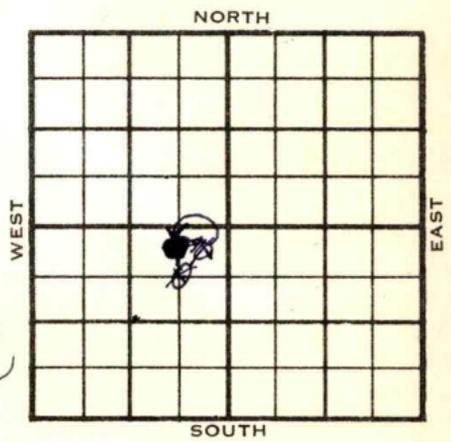

~~NE NE SW~~

C N 1/2 NE SW

1955	ELEVATION	REPORT
	1752'	
12-28	Comm. 12-20-55 Drlg. 1870	
<u>1956</u>		
1-25	8 5/8" @ 210/250 5 1/2" @ 4285 DD 4286 500 A S/ 24 bo 28% wtr. Comp. 35 bopd, 20 BW M. 4016 V. 4283 1/2 TD 4286'	

COMPLETED

County Kingman Elev. _____
 Sec. 14 Twp. 27 Rge. LOW
 Company Bennett & Roberts
 Farm Name Sales No. 4

TOPS	DEPTH	LOG	DATUM
Anh.			
Tp.			
H.			
Tr.			
Dg.			
Bl.			
L.			
K.C.			
B.K.C.			
Ce.			
C.			
M.			
M.			
K.			
Mz.			
Me.			
V.			
S.			
S.			
A			
R.			
Pe.			
G.			
T.D.			

Loc. in Sec. NE SW
 Geol. _____
 Contr. _____
 Co. tools _____
 Pool Drisden
 FIRST REPORT
 DEC 28 '55

Date Comm. 12-20-55
 drlg. 1870

~~28~~

Co.
Lse.
No.
Sec.
T.
R.

CORRECTION

FORM 513 REV. SUNRAY

County Kingman Elev. _____
 Sec. 14 Twp. 27 Rge. 10W
 Company Bennett & Roberts
 Farm Name Sales No. 4

TOPS	DEPTH	LOG	DATUM	Loc. in Sec.
Anh.				C N $\frac{1}{2}$ NE SW
Tp.				
H.				
Tr.				
Dg.				
Bl.				
L.				Geol. _____
K.C.				Contr. _____
B.K.C.				
Ce.				
C.				
M.				
M.				Pool
K.				
Mz.				
Mq.				
V.				
S.				
S.				
A.				
R.				
Pe.				
G.				
T.D.				



Date Comm. JAN 25 1956
 Reported NE NE SW

Co.
Lse.
No.
Sec.
T.
R.

County Kingman Elev. 1752
 Sec. 14 Twp. 27 Rge. 10W
 Company Bennett & Roberts
 Farm Name Sales No. 4

TOPS	DEPTH	LOG	DATUM	Loc. in Sec.												
Anh.				C N $\frac{1}{2}$ NE SW												
Tr.																
Dg.				Geol.												
Bl.																
L.				Contr.												
K.C.																
B.K.C.				Co. tools												
Ce.																
C.				Pool												
M.	<u>4016</u>		<u>2264</u>													
M.				Drisden												
K.																
Mz.				<table border="1"> <tr> <td></td> <td></td> <td></td> <td></td> </tr> <tr> <td colspan="4" style="text-align: center;">COMPLETE</td> </tr> <tr> <td></td> <td></td> <td></td> <td></td> </tr> </table>					COMPLETE							
COMPLETE																
V.	<u>4285 1/2</u>		<u>2531</u>													
S.																
S.																
A.																
R.																
PE.																
G.																
T.D.	<u>4285 1/2</u>															

Date Comm. 12-20-55 JAN 25 1956

8 5/8" @ 210/250 5 1/2" @ 4285 DD 4286

500 A S/ 24 bo 28% wtr.

Comp. 35 bopd 20 bw

Co.
Lse.
No.
Sec.
T.
R.