


Section 10 Township 27 Range 39-W

Well No. #1 Brattin

Company Stanolind

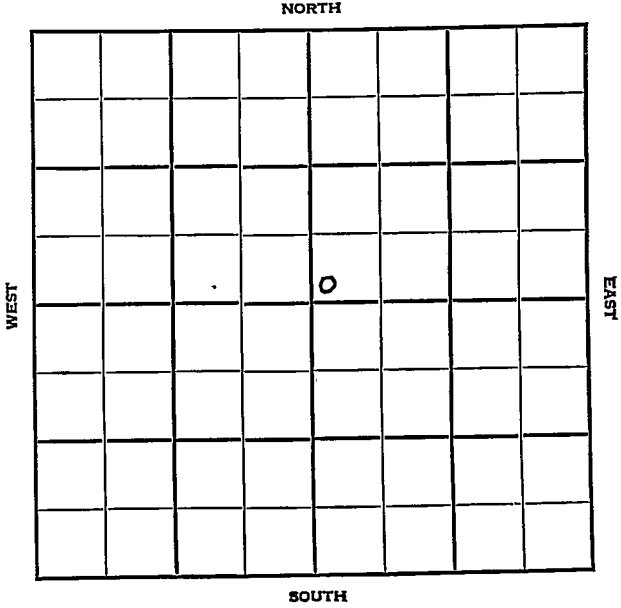

KANSAS

Stanton



Sec. 10 Twp. 27 R. 39W

Well No. #1 Brattin Farm
Stanolind Company

Hugoton Pool


Ft. from N. Line

150' Ft. from S. Line

Ft. from E. Line

150' Ft. from W. Line

SW NE

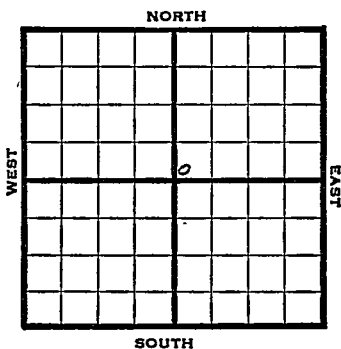

1948 Elev. 3210' REPORT

5/12 10" @ 564'
1945 fsg.

5/19 TD 2338'
7" @ 2330'

5/26 TD 2537'

6/1 "

6/9 7" @ 2330'
116' of 5" perf. liner @ 2537'
15,500 acid
6,129,000 Gas
410# R. Pr.
TD 2537'
Comp.

COMPLETED

Map No. _____ Sec. 10 Twp. 27 R. 39W

Well No. 1 Brattin

Stanolind Company

FIRST REPORT

Contractor _____

SW NE

SECTION PLAT

		o	

_____ Ft. from N. Line

150 Ft. from S. Line

_____ Ft. from E. Line

150 Ft. from W. Line

Stanton County

Location _____

Rig up _____

Drilling and Remarks:

10" @ 564

1945 fsg.

RECORD

Cased _____ in., _____ ft.

Sand _____

Gas _____

Oil _____

Total Depth _____

PRODUCTION

1st 24 hrs. Nat. _____

1st 24 hrs. after shot _____

Gas _____ Cu. Ft.

Dry Hole _____

Abandoned _____

Date

MAY 12 1948

19

S. J. LEWIS

Scout

Map No. _____ Sec. 10 Twp. 27 R. 39W

Well No. 1 Brattin

Stanolind Company

COMPLETE

Contractor

SW NE

E. 2210

SECTION PLAT

_____ Ft. from N. Line

150 Ft. from S. Line

_____ Ft. from E. Line

150 Ft. from W. Line

		0	

Stanton County

Location _____

Rig up _____

Drilling and Remarks:

9 "C2230
116' of 8" Pay line
C 2587
15500 acid
6,129,000 Gas
410# R/R

RECORD

Cased _____ in., _____ ft.

Sand _____

Gas _____

Oil _____

Total Depth 2587

PRODUCTION

1st 24 hrs. Nat. _____

1st 24 hrs. after shot _____

Gas _____ Cu. Ft.

Dry Hole _____

Abandoned _____

Date

JUN 9 1948 19

S. J. LEWIS Scout