

KANSAS


Kingman

Section 10 Township 27 Range 7W

Well No. #1 Collingwood

H.K. PORTER

Company W.H. Gaddis et al.

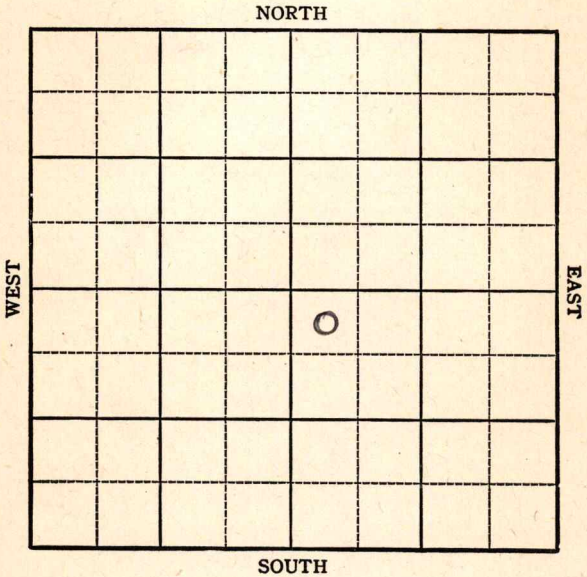

Sec. 10 Twp. 27 R. 7W

Well No. #1 Collingwood Farm

H. K. PORTER

W. H. Gaddie et al.

Company

Wildcat


330 Ft. from N. Line

_____ Ft. from S. Line

_____ Ft. from E. Line

330 Ft. from W. Line

Elev. 1532

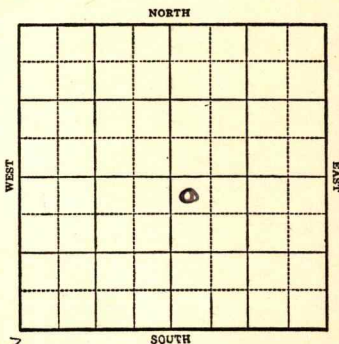

1944

R E P O R T

3/8 Location

3/16 Derrick

3/22 "

3/29 "

4/5 Rotary

4/12 10" @ 259

Drlg. 260

4/19 **Anhy 980**

Lans 3119

Drlg. 3300'

*3803
1532

2271*

4/26 Miss 3803

Drlg. 3835

5/3 **Kind 3981**

Viola 4118 SSO 4121-23

Simp 4132

Arb 4238

TD4288

Run csg. test Lans.

5/10 26 shots 3800-26 Wtr. show gas

SSO sq.

*3800
1532

2268
20

2294*

5/17 8 shots 3823-30

12 shots 3808-13 $\frac{1}{2}$ SS gas

*4132
1532

2600*

OVER

1944

5/24

5" @ 3940

Arb 4238

Td 4288

Water

50

ABANDONED

KANSAS

Map No. 36 Sec. 10 Twp. 27 R. 7W

Well No. 1 Collingwood

W. H. Gaddis et al. Company

FIRST REPORT Contractor

NW SE

SECTION PLAT

330 Ft. from N. Line

_____ Ft. from S. Line

_____ Ft. from E. Line

330 Ft. from W. Line

		o	

Wildcat

Location X

Rig up _____

Drilling and Remarks:

RECORD

Cased _____ in., _____ ft.

Sand _____

Gas _____

Oil _____

Total Depth _____

PRODUCTION

1st 24 hrs. Nat. _____

1st 24 hrs. after shot _____

Gas _____ Cu. Ft.

Dry Hole _____

Abandoned _____

Date

MAR 8 1944 19

S. J. LEWIS Scout