

KANSAS

Grant

Section 11 Township: 27 Range 37W

Well No. #1 R Moore

Company Magnolia

Hugoton

NORTH

				0			

WEST

EAST

SOUTH

Sec. 11 Twp. 27 R. 37W

Well No. 1 R. Moore Farm

Magnolia Company


Malleney Contr. Hugoton Pool

_____ Ft. from N. Line

330 Ft. from S. Line

_____ Ft. from E. Line

330 Ft. from W. Line

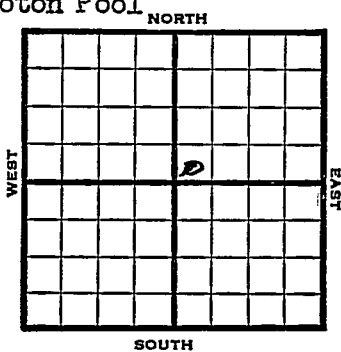

1949

Elev. 3098' REPORT

- 7/27 8" @ 769'
- 8/6 Drlg. 2505'
- 8/10 TD 2660'
7" @ 2659'
- 8/17 356 shots 2472-2618 - 21,000 acid
- 8/24 168 shots 2412-2454-14,000 acid
- 8/31 "
- 9/7 7" @ 2659'
Perf
Acid 35,000
Gas 19,300,000
R. Pr. 360#
TD 2660'

COMPLETED

Kansas

Hugoton Pool

Map No. _____ Sec. 11 Twp. 27 R. 37W

Well No. 1 R. Moore

Magnolia Company

Mal leney Contractor

**FIRST REPORT
SECTION PLAT**

SW NE

_____ Ft. from N. Line

330

_____ Ft. from S. Line

_____ Ft. from E. Line

330

_____ Ft. from W. Line

Grant County

RECORD

Location _____

Cased _____ in., _____ ft.

Rig up _____

Sand _____

Drilling and Remarks:

Gas _____

8" @ 769

Oil _____

Total Depth _____

PRODUCTION

1st 24 hrs. Nat. _____

1st 24 hrs. after shot _____

Gas _____ Cu. Ft.

Dry Hole _____

Abandoned _____

Date

JUL 27 1949 19

S. J. LEWIS Scout

Map No. 1 Sec. 11 Twp. 27 R. 37W

Well No. 1 R. Moore

Magnolia Company

COMPLETE

Contractor

SW NE

E 13098
SECTION PLAT

		o	

Ft. from N. Line

330 Ft. from S. Line

Ft. from E. Line

330 Ft. from W. Line

Grant County

RECORD

Location _____

Cased _____ in., _____ ft.

Rig up _____

Sand _____

Drilling and Remarks:

Gas _____

7" C2659

Oil _____

Perf

Total Depth 2660

20000 acid

19,300,00 Cu

360# RPL

PRODUCTION

1st 24 hrs. Nat. _____

1st 24 hrs. after shot _____

Gas _____ Cu. Ft.

Dry Hole _____

Abandoned _____

Date

SEP 7 1949 19

S. J. LEWIS Scout