


Section 11 Township 27 Range 1-W

Well No. #1 Slesse *(Slesse)*

Company Drillers Gas
Curry Pool

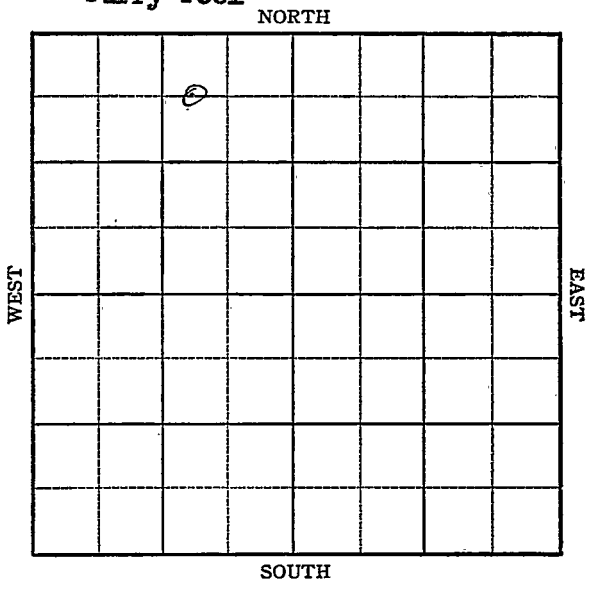

Sec. 11 Twp. 27 R. 1W ✓

Well No. #1 Slesse Farm

Drillers Gas Company


Curry Pool (Springer & Harper, Contr.)

660' Ft. from N. Line

_____ Ft. from S. Line

990' Ft. from E. Line

_____ Ft. from W. Line

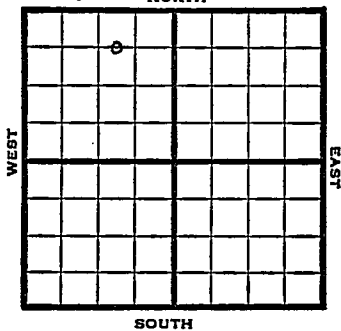

C W L NE NW

1949 Elev. 1324 REPORT

- 11/16 8" @ 216'
- 11/23 Drlg. 2695'
- 11/29 TD 3425'
- 5" @ 3424'
- 12/7 Lansing 2589'
- Miss 3080'
- Simpson 3419'
- TD 3430' W
- 12/14 "
- 12/28 Miss 2589'
- Simp 3411'
- 5" @ 3424
- 200 acid
- Pump 20 oil Pot.
- Gr. 41°
- TD 3430'

COMPLETED

Map No. _____ Sec. 11 Twp. 27 R. 1W

Well No. 1 Slesse

_____ Drillers Gas _____ Company

_____ Springer & Harper _____ Contractor

* C W L NE NW

FIRST REPORT
SECTION PLAT

660 Ft. from N. Line

_____ Ft. from S. Line

990 Ft. from E. Line

_____ Ft. from W. Line

	o		

Sedgwick County

Location _____

Rig up _____

Drilling and Remarks:

8" @ 216

RECORD

Cased _____ in., _____ ft.

Sand _____

Gas _____

Oil _____

Total Depth _____

PRODUCTION

1st 24 hrs. Nat. _____

1st 24 hrs. after shot _____

Gas _____ Cu. Ft.

Dry Hole _____

Abandoned _____

Date

NOV 16 1949 19 _____

S. J. LEWIS

Scout

Kansas

Map No. _____ Sec. 11 Twp. 27 R. 1WWell No. 1 Slesse

Drillers Gas _____ Company _____

COMPLETE

Contractor

C W L NE NW

E. 1324
SECTION PLAT660 Ft. from N. Line

_____ Ft. from S. Line

990 Ft. from E. Line

_____ Ft. from W. Line

	0		

Sedgwick County

Location _____

Rig up _____

Drilling and Remarks:

Misc 2589
Sump 3419
5th C 3424
200 acid
Pump 200 oil 1st
410-30

RECORD

Cased _____ in., _____ ft.

Sand _____

Gas _____

Oil _____

Total Depth 3430

PRODUCTION

1st 24 hrs. Nat. _____

1st 24 hrs. after shot _____

Gas _____ Cu. Ft.

Dry Hole _____

Abandoned _____

Date

DEC 28 1949

19

S. J. LEWIS

Scout