


Map No. KANSAS Sec. 11 Twp. 27 R. 1W

Well No. 1-Schwenker Farm

Lassen et al Company

(Schwenker)

NORTH

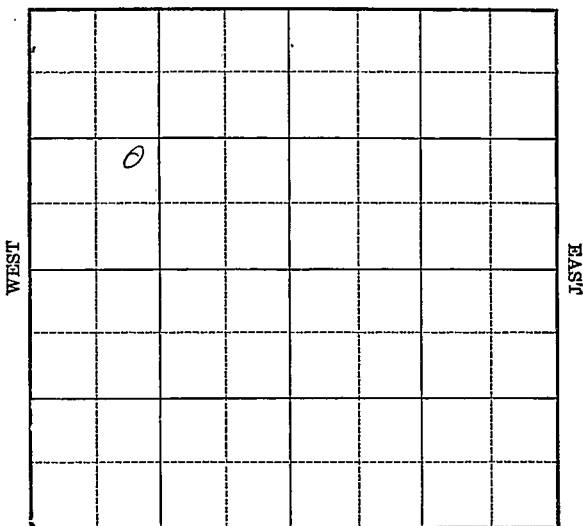

Location \_\_\_\_\_  
Drilling Remarks \_\_\_\_\_

Rig Up \_\_\_\_\_  
Drilling Remarks \_\_\_\_\_

\_\_\_\_\_  
\_\_\_\_\_  
**RECORD**

Cased \_\_\_\_\_ in. \_\_\_\_\_ ft.  
Sand \_\_\_\_\_  
Gas \_\_\_\_\_  
Oil \_\_\_\_\_  
Total Depth \_\_\_\_\_

**PRODUCTION**

1st 24 hrs. Nat. \_\_\_\_\_  
1st 24 hrs. after shot \_\_\_\_\_  
Gas \_\_\_\_\_ cu. ft. \_\_\_\_\_  
Dry Hole \_\_\_\_\_  
Abandoned \_\_\_\_\_

*Sedgwick*

**KANSAS**

Map No. \_\_\_\_\_ Sec. 11 Twp. 27 R. 1<sup>W</sup>

Well No. 1-Schwertner Farm

Jassen et al Company


NORTH

\_\_\_\_\_ Ft. from N. Line

1120 Ft. from S. Line

\_\_\_\_\_ Ft. from E. Line

1120 Ft. from W. Line

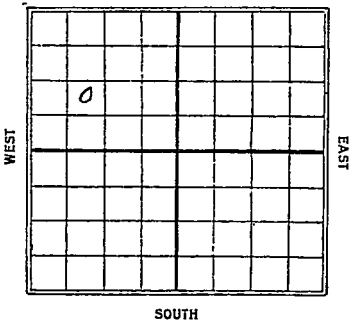

Date	REPORT
1930	
9/3	R. O. G.
9/10	Kell
9/17	Spull
9/24	Run 47 ft of 20"
10/1	Wdly 800'
10/8	" 1685'
10/15	Run 10"-20 1/2'
10/22	Wdly 2500'
10/29	" 2820'
11/3	Top Chat 3412' Wdly 3414'
11/12	" 3419'
11/19	Case Miss 3341 Wdly 3374'
11/25	Wilcox 3457' N7W 3462-68'
	Wdly 3520'
12/2	Top Oil line 3532
	TD 3533
	Dry & Abandon

*38*  
*Scout*

Map No. KANSAS Sec. 11 Twp. 27 R. 1W

Well No. 1 Sc. in 22 1/2

Louise & Co. Company

Contractor

**SECTION PLAT**

0			

\_\_\_\_\_ Ft. from N. Line

1120 Ft. from S. Line

\_\_\_\_\_ Ft. from E. Line

1120 Ft. from W. Line

**FIRST REPORTS**

Location \_\_\_\_\_

Rig up \_\_\_\_\_

Drilling and Remarks:

*ROY*

**RECORD**

Cased \_\_\_\_\_ in., \_\_\_\_\_ ft.

Sand \_\_\_\_\_

Gas \_\_\_\_\_

Oil \_\_\_\_\_

Total Depth \_\_\_\_\_

**PRODUCTION**

1st 24 hrs. Nat. \_\_\_\_\_

1st 24 hrs. after shot \_\_\_\_\_

Gas \_\_\_\_\_ Cu. Ft.

Dry Hole \_\_\_\_\_

Abandoned \_\_\_\_\_

Date

SEP 3 1930

19

**S. J. LEWIS**

Scout

Map No. 38 **KANSAS** Sec. 11 Twp. 27 R. 1W

Well No. 1 Schwertner

Lassen & Co Company

Contractor

**SECTION PLAT**

0			

..... Ft. from N. Line

1120 Ft. from S. Line

..... Ft. from E. Line

1120 Ft. from W. Line

~~ARRANGED~~

Location.....

Rig up.....

Drilling and Remarks:

Top Sil. lime  
3582.

**RECORD**

Cased..... in., ..... ft.

Sand.....

Gas.....

Oil.....

Total Depth 3583

**PRODUCTION**

1st 24 hrs. Nat.....

1st 24 hrs. after shot.....

Gas..... Cu. Ft.

Dry Hole.....

Abandoned.....

Date

DEC 3 1930

S. J. LEWIS Scout