


Pratt

KANSAS

SECTION 35 TOWNSHIP 27 RANGE 12W

WELL NO. #1^b Shirk

COMPANY Falcon-Seaboard

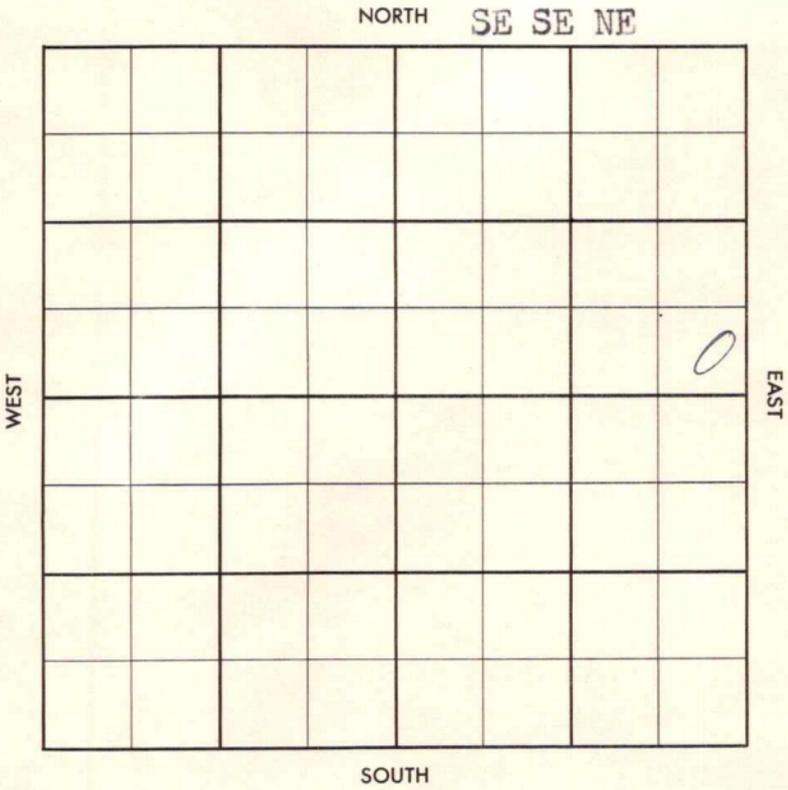

2987P

WILDCAT

FORM 513 SUNRAY

County Pratt Elev. _____
 Sec. 35 Twp. 27 Rge. 12W
 Company Falcon-Seaboard
 Farm Name Shirk No. 1

TOPS	DEPTH	LOG	DATUM
Anh.			
TP.			
H.			
Tr.			
Dg.			
BL.			
L.			
K.C.			
B.K.C.			
Ce.			
C.			
M.			
M.			
K.			
Mz.			
Me.			
V.			
S.			
S.			
A			
R.			
PE.			
G.			
T.D.			

Loc. in Sec. SE SE NE

Geol. _____
Contr. Co. tools

Pool Wildcat

FIRST REPORT

FEB 6 '37

Date Comm. RUR

~~26~~

Co.
Lsc.
No.
Sec.
T.
R.

County Pratt Elev. 1762 DF
 Sec. 35 Twp. 27 Rgs. 12W
 Company Falcon-Seaboard
 Farm Name Shirk No. 1-B

TOPS	DEPTH	LOG	DATUM	Loc. in Sec.
Anh.				SE SE NE
Tp.				
H.	3402			
Tr.	3412			
Dg.				
Bl.	3588			
L.	2610			
K.C.				Geol.
B.K.C.				Contr.
Ce.				Co. tools
C.	chat	4058	4052	
M.	LI	4116	4115	Pool
K.		4187	4190	Wildcat
Mz.				
Mo.				
V.	4253	4250		
S.	4360	4352		
S.				
A.	4448	4443		
R.				
Pe.				
G.				
T.D.	4501			

ABANDONED
 MAR 3 '57

Date Comm.
 R U R FEB 13 '57 SKID 30' south
 2-8-57 ID 596 FEB 20 '57 Lost circ
 @ 2104 FEB 27 '57 878 821 ID
 3754 MAR 13 '57
 D&A