

Section 12 Township 27 Range 13 WWell No. # 1 S. BeckCompany Skelly Oil

|  |  |  |  |  |  |  |   |
|--|--|--|--|--|--|--|---|
|  |  |  |  |  |  |  |   |
|  |  |  |  |  |  |  |   |
|  |  |  |  |  |  |  | 0 |

NORTH

WEST

EAST

SOUTH

Pratt

KANSAS

Sec. 12 Twp. 27 R. 13WWell No. #1 S. Beck FarmSkelly Oil Company

Contractor

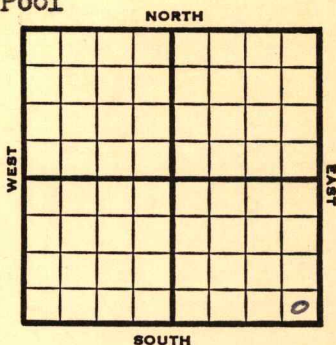
## Iuka-Carmi Pool

Ft. from N. Line

330 Ft. from S. Line330 Ft. from E. Line

Ft. from W. Line

SE SE SE

1953 **Elev. 1870'** REPORT

5/27

Location

6/3

Drlg. 600'

6/10

8" @ 731

Drlg. 2920'

6/24

Heeb 3513, Br li 3692, Lans 3707,  
B KC 4049, Miss Li 4152, V 4196, Simp  
4233

RTD 4322

5" @ 4322, CO

7/1

48/4271-79 Sd-O-frac. S/1 BO &  
2 BWPH 6 hrs. PB 4269 36/4262-68  
Sd-O-frac S/208 BO plus 2 BW 22 hrs.

7/8

NR

7/15

Spud 5-31-53

Oil Well

TD 4322'

8" @ 731'

Heeb 3513, Br. Lime 3692, Lans 3707,  
B KC 4049, Miss 4152, Viola 4196,  
Simp 4233

TD 4322

5" @ 4322'

48/ 4271-79 sd-oil-frac

S/ 1 bo 2 bwph 6 hr. PB 4269

36/ 4262-68 sd-oil-frac S/ 208 bo

2 bw 22hr. P/ 50 bo 10 hr.

Comp. 163 bopd.

COMPLETED

County Pratt State KansasSec. 12 (Blk. 27 (Sur. 13W Map No. 13W)  
(Twp.) (Rge.)Operator Skelly OilWell No. 1 Farm S. BeckElev. \_\_\_\_\_ Location SE SE SE

|  |  |  |  |  |  |  |  |  |  |
|--|--|--|--|--|--|--|--|--|--|
|  |  |  |  |  |  |  |  |  |  |
|  |  |  |  |  |  |  |  |  |  |
FIRST REPORT

330 Ft. From S Line SE330 Ft. From E Line Quarter1st. Report MAY 27 1953

Completion \_\_\_\_\_

Remarks \_\_\_\_\_

Spudding Date \_\_\_\_\_

Drlg. Data Iuka-Carmi PoolLocation



( Blk. )  
( Twp. )

Skelly Oil

1-A Farm S. Beck

|      |          |    |    |    |
|------|----------|----|----|----|
| 1870 | Location | SE | SE | SE |
|------|----------|----|----|----|

COMPLETE

330 Ft. From E Line Quarter

Completion JUL 15 1953

Spudding Date 5-31-53

Oil well      TD 4322

Lans. 3707    B KC 4049    Miss. 4152

Viola 4196      Simp/ 4233      TD 4322

5" @ 4322 48/ 4271-79 sd-oil-frac

S/ 1 bo 2 bwph 6 hr. PB 4269

36/ 4262-68      sd-oil-frac      S/ 208 bo

2 bw 22 hr. P/ 50 bo 10 hr.

Comp. 163 bond

J. G. McGILL