


KANSAS

Grant

Section 12 Township 27 Range 38WWell No. #1 Waechter "D"Company Stanolind

Hugoton Pool

NORTH

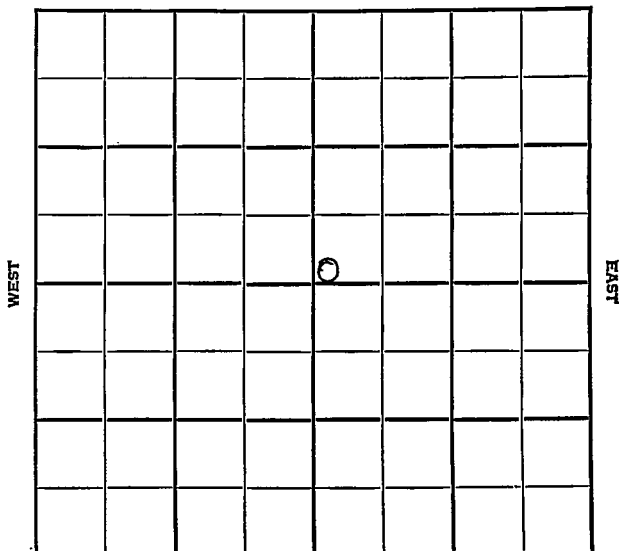

SOUTH

KANSAS


Grant

Sec. 12 Twp. 27 R. 38WWell No. #1 Waechter "D" FarmStanolind Company

Hugoton Pool

 Ft. from N. Line150' Ft. from S. Line Ft. from E. Line150' Ft. from W. Line

SW NE

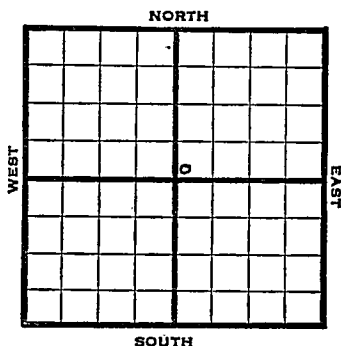

1948

Elev. 3084' REPORT

2/18 Location.
2/25 "
3/3 "
3/10 691 Running csg.
3/17 10" @ 685'
Drlg. 1750'
3/24 TD 2375'
7" @ 2338'
RUST
3/31 "
4/7 Drlg. 2531'
4/14 TD 2579'
4/21 7" @ 2338'
257' of 5" Perf liner @ 3579'
Acid 17,000
Gas 11,139,000
R. Pr. 425#
TD 2579'

COMPLETED

Map No. _____ Sec. 12 Twp. 27 R. 38W

Well No. 1 Waechter "D"

Stanolind Company

FIRST REPORT

_____ Contractor

SW NE

SECTION PLAT

		o	

_____ Ft. from N. Line

150 Ft. from S. Line

_____ Ft. from E. Line

150 Ft. from W. Line

Grant County

Location X

Rig up _____

Drilling and Remarks:

RECORD

Cased _____ in., _____ ft.

Sand _____

Gas _____

Oil _____

Total Depth _____

PRODUCTION

1st 24 hrs. Nat. _____

1st 24 hrs. after shot _____

Gas _____ Cu. Ft.

Dry Hole _____

Abandoned _____

Date

FEB 18 1948 19 S. J. LEWIS Scout

Map No. _____ Sec. 2 Twp. 27 R. 38WWell No. 1 Waechter "C"

Stanolind

Company

COMPLETF

Contractor

SW NE

E 1.3/46

SECTION PLAT

_____ Ft. from N. Line

150 Ft. from S. Line

_____ Ft. from E. Line

150 Ft. from W. Line

Grant County

Location _____

Rig up _____

Drilling and Remarks:

7" @ 2416

236' 2 1/2" Perforance

@ 2620

170000 acs/c

2, 740, 000 lbs

410 2R/Pr

RECORD

Cased _____ in., _____ ft.

Sand _____

Gas _____

Oil _____

Total Depth 2620

PRODUCTION

1st 24 hrs. Nat. _____

1st 24 hrs. after shot _____

Gas _____ Cu. Ft.

Dry Hole _____

Abandoned _____

Date

JUN 16 1948 19

S. J. LEWIS Scout