

~~KANSAS~~


Grant

Section 12 Township 27 Range 37N

Well No. #1 Lewis - Walker

Company Magnolia
Hugoton Pool

NORTH

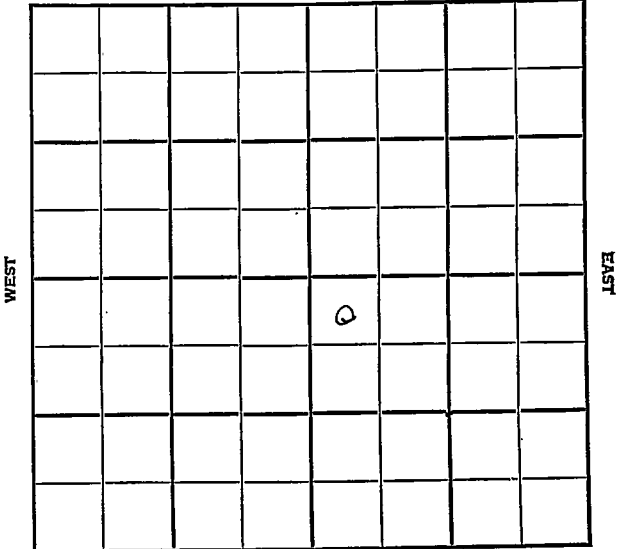


SOUTH

Sec. 12 Twp. 27 R. 37 WWell No. #1 Lewis-Walker FarmMagnolia Company

Houghton Pool

330 Ft. from N. Line Ft. from S. Line Ft. from E. Line330 Ft. from W. Line

NW SE

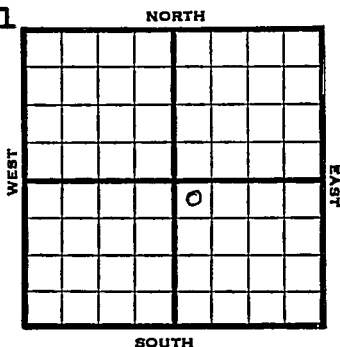

1948

Elev. 3072' REPORT

4/21

10" @ 751'

Drlg. 1307'

4/28

TD 2740'

7" @ 2740'

5/5

168 shots 2604-40 7000 acid

120 " 2557-84 7000 "

5/12

72 shots 2502-20' - 7000 acid.

72 shots 2458-67' - 7000 acid.

5/19

"

6/1

7" @ 2740'

Perf.

Acid 28,000

Gas 13,200,000

R. Pr. 405#

TD 2740'

COMPLETED

Map No. _____ Sec. 12 Twp. 27 R. 37W

Well No. 1 Lewis - Walker

Magnolia Company

FIRST REPORT

Contractor _____

NW SE

SECTION PLAT

330 Ft. from N. Line

_____ Ft. from S. Line

_____ Ft. from E. Line

330 Ft. from W. Line

		o	

Grant County

Location _____

Rig up _____

Drilling and Remarks:

10" @ 751

drlg. 1307

RECORD

Cased _____ in., _____ ft.

Sand _____

Gas _____

Oil _____

Total Depth _____

PRODUCTION

1st 24 hrs. Nat. _____

1st 24 hrs. after shot _____

Gas _____ Cu. Ft.

Dry Hole _____

Abandoned _____

Date

APR 21 1948 19 S. J. LEWIS Scout

Map No. _____ Sec. 12 Twp. 27 R. 37W

Well No. 1 Lewis - Walker

Magnolia Company

COMPLETE

Contractor

NW SE


E 13092
SECTION PLAT

330 Ft. from N. Line

_____ Ft. from S. Line

_____ Ft. from E. Line

330 Ft. from W. Line

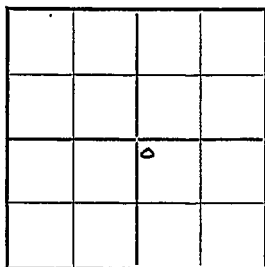

Grant County

Location _____

Rig up _____

Drilling and Remarks:

7" @ 2740

Perf.

28000 acft. C

13,200,000 Gas

H.S. R/P

RECORD

Cased _____ in., _____ ft.

Sand _____

Gas _____

Oil _____

Total Depth 2740

PRODUCTION

1st 24 hrs. Nat. _____

1st 24 hrs. after shot. _____

Gas _____ Cu. Ft.

Dry Hole _____

Abandoned _____

Date

JUN 1 1948

19

S. J. LEWIS

Scout