


KANSAS Grant

Section 12 Township 27 Range 36W

Well No. 1 Hoffman "G"

Company Columbian Fuel

Hugoton
NORTH

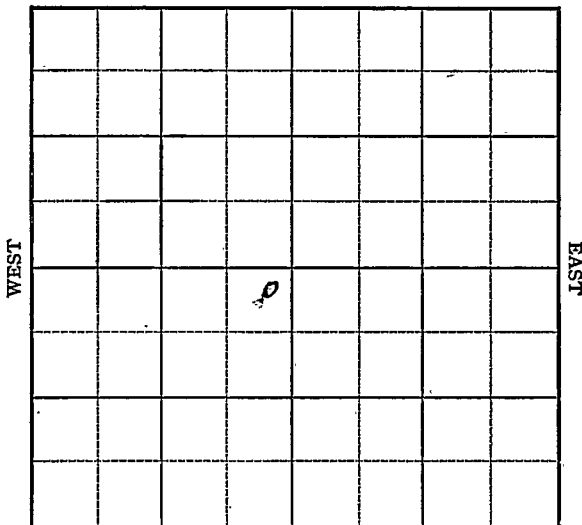

SOUTH

Sec. 12 Twp. 27 R. 36W

Well No. #1 Hoffman "C" Farm

Columbian Fuel

Company

Hugoton Pool


100' Ft. from N. Line

_____ Ft. from S. Line

100' Ft. from E. Line

_____ Ft. from W. Line

NE SW

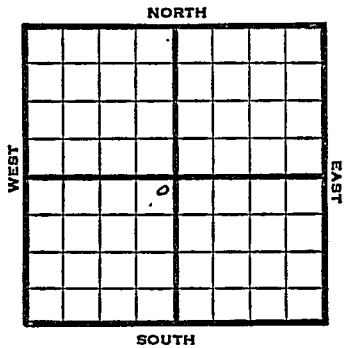

1949

Elev. 3099' REPORT

7/6

Location

7/12

"

7/20

10" @ 600'

TD 2550'

7" @ 2544'

7/27

"

8/3

"

8/10

"

8/17

"

8/24

TD 2741-203' of 5" Perf liner @ 2741'

8/31

15000 acid

9/7

7" @ 2544'

203' of 5" Perf liner @ 2741'

Acid 15,000 acid

Gas 16,372,000

TD 2741'

R. Pr. 418#

COMPLETED

Map No. _____ Sec. 12 Twp. 27 R. 36W

Well No. I Hoffman "C"

Columbian Fuel Company

Contractor

NE SW

FIRST REPORT
SECTION PLAT

100 Ft. from N. Line

_____ Ft. from S. Line

100 Ft. from E. Line

_____ Ft. from W. Line

	o		

Grant County

Location X

Rig up _____

Drilling and Remarks: _____

RECORD

Cased _____ in., _____ ft.

Sand _____

Gas _____

Oil _____

Total Depth _____

PRODUCTION

1st 24 hrs. Nat. _____

1st 24 hrs. after shot _____

Gas _____ Cu. Ft.

Dry Hole _____

Abandoned _____

Date

JUL 6 1949 19

S. J. LEWIS

Scout

Map No. 1 Sec. 12 Twp. 27 R. 36W

Well No. 1 Hoffman "C"

Columbian Fuel Company

COMPLETE

Contractor

E. 13099

SECTION PLAT

NE SW

	0		

100 Ft. from N. Line

 Ft. from S. Line

100 Ft. from E. Line

 Ft. from W. Line

Grant County

RECORD

Location

Cased in., ft.

Rig. up

Sand

Drilling and Remarks:

Gas

7" @ 2544

Oil

203' of 5" Pipe liner

Total Depth 2741

@ 2741

PRODUCTION

15000000 @

1st 24 hrs. Nat.

16,372,500 Gall

1st 24 hrs. after shot

Gas Cu. Ft.

Dry Hole

Abandoned

H. J. R. R.

Date

SEP 7 1949 19

S. J. LEWIS Scout