

Section 12 Township 27 Range 35WWell No. #1 C. Ladner (C)Company Columbian Fuel

NORTH

				0			

WEST

EAST

SOUTH

Grant

KANSAS

Sec. 12 Twp. 27 R. 35W

Well No. #1 C. Ladner (C) Farm

Columbian Fuel Company

Contractor

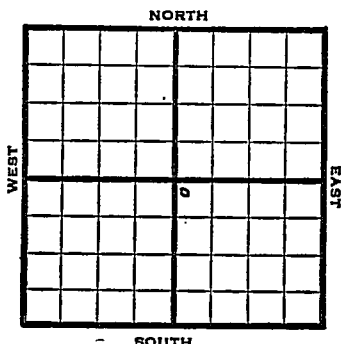
100' Ft. from N. Line

_____ Ft. from S. Line

_____ Ft. from E. Line

100' Ft. from W. Line

100 S& E of C



1952 Elev. 3021' REPORT

2/27	Spud 2-21-52	
	10" @ 549	
	Drlg. 2200'	
3/4	RTD 2560	6" @ 2551 WOC
3/12	NR	
3/19	NR	
3/25	Drlg. plug	
4/1	TD 2747'	
4/9	NR	
4/23	"	
4/30	"	
5/7	Krider 2571	Winfield 2636
	Up Ft. 2679	Low Ft 2729
5/14	NR	
5/21	"	
5/28	"	
6/11	"	
6/18	"	
6/25	"	
7/2	"	
7/9	"	
7/17	"	
7/23	"	
7/30	"	
8/6	"	

OVER

1952

8/13 NR

8/20 "

8/27 "

9/3 "

9/10 "

9/17 "

9/24 "

10/1 "

10/8 "

10/15 "

10/22 "

10/29 "

11/5 "

11/12 "

11/20 "

11/27 "

12/4 "

12/10 Spud 2-21-52

Gas Well

TD 2747

10" @ 549'

6" @ 2551

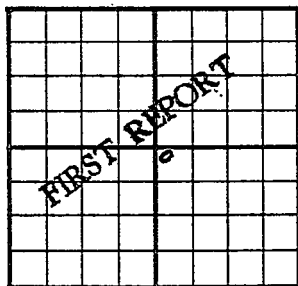
TD 2747

Kri 2571, Win 2636, Ft. Riley

2679', 15000A

Comp. 15,992,000 gas

COMPLETED

County Grant State KansasSec. 12 (Blk.) 27 (Sur. Rge.) 35W Map No.Operator Columbian FuelWell No. 1 Farm C. Ladner (C)Elev. Location 100 S & E of C100 Ft. From N Line SE100 Ft. From W Line Quarter1st. Report FEB 27 1952

Completion

Remarks

Spudding Date 2-21-52

Drlg. Data

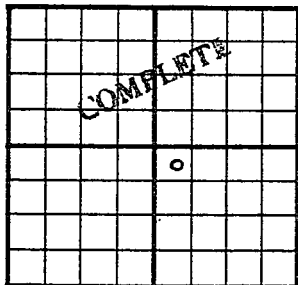
10" @ 549 Drlg. 2200

J. G. McGEHEE

FEB 28 1952

Scout Cards	_____
Land Small Map	_____
Land Wall Map	_____
Tracings	_____
France Map	_____
Pierce Map	_____
Misc.	_____

Drig. Data

County Grant State KansasSec. 12 (Blk. Twp.) 27 (Sur. Rge.) 35W Map No.Operator Columbian FuelWell No. 1 Farm C. Ladner "C"Elev. 3021 Location NW SE100 Ft. From N Line SE100 Ft. From W Line Quarter

1st. Report

Completion DEC 10 1952

Remarks

Spudding Date 2-21-52Drig. Data Gas well TD 274710" @ 549 6" @ 2551 TD. 2747Kri. 2571 Win. 2636 Ft. Riley 267915000 A Comp. 15,992,000 gas

Scout Cards	_____
Land Small Map	_____
Land Wall Map	_____
Tracings	_____
France Map	_____
Pierce Map	_____
Misc.	_____

DEC 17 1952