


Section 12 Township 27 Range 13-W

Well No. #2 Beck

Company Magnolia
Iuka Pool

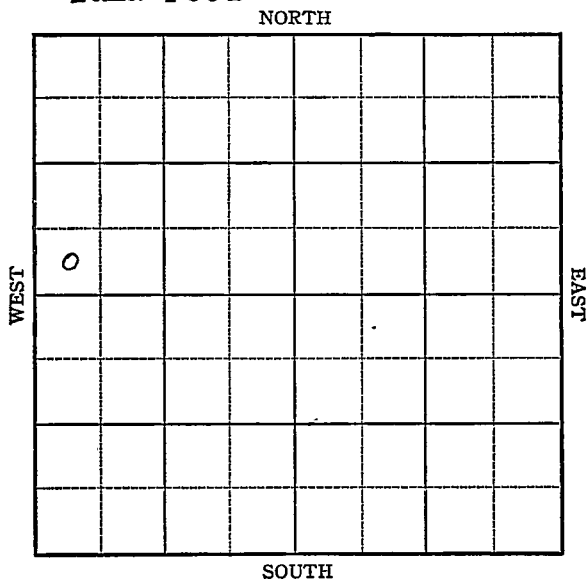

Sec. 12 Twp. 27 R. 13-WWell No. #2 Beck FarmMagnolia Company

Iuka Pool


Ft. from N. Line

326 Ft. from S. Line

Ft. from E. Line

330 Ft. from W. Line

Elev. 1925

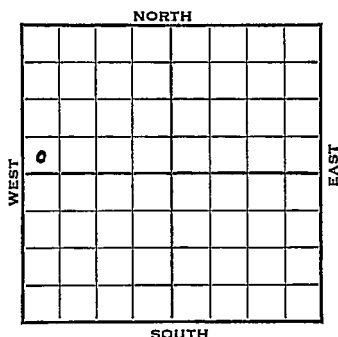

1942

REPORT

7/29

Rotary.

8/5

10" - 637

Drlg. 2265'

8/12

Drlg. 3900

8/19

Viola 4198

Simp. sd 4313-17 T.D.

Sat 5" - 4314 RUST.

8/27

TD 4318 2000 acid swb 13 oil per
hr.

9/2

Temp. Pot. 48 bbls oil

9/9

" " "

9/16

" " "

9/23

T. D. 4332

Swab 219 oil 6 1/2 hrs (Check this)

9/30

TD 4332 shut in.

10/7

" "

10/14

" "

10/21

" "

10/28

Simp. 4313

5" - 4314

2000 acid

T.D. 4332

Pump 198 Pot.

Gravity 37.

COMPLETED

Map No. 92 Sec. 12 Twp. 27 R. 13WWell No. 2 BeckMagnolia

Company

FIRST REPORT

Contractor

SW NW

SECTION PLAT

5			

 Ft. from N. Line326 Ft. from S. Line Ft. from E. Line330 Ft. from W. Line**IUKA POOL**Location Rig up Drilling and Remarks: **Rotary**

RECORD

Cased in., ft.Sand Gas Oil Total Depth

PRODUCTION

1st 24 hrs. Nat. 1st 24 hrs. after shot Gas Cu. Ft.Dry Hole Abandoned

Date

JUL 29 1942

19

S. J. LEWIS

Scout

Map No. 92 Sec. 12 Twp. 27 R. 13WWell No. 2 BeckMagnolia


Company

COMPLETED

Contractor

SW NW

SECTION PLAT

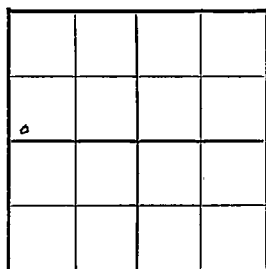 Ft. from N. Line326 Ft. from S. Line Ft. from E. Line330 Ft. from W. Line

IUKA POOL

Location Rig up

Drilling and Remarks:

*Shut 4313**5" @ 4314**2000 acid**Prod. 1988**270 Gr*

RECORD

Cased in., ft.Sand Gas Oil Total Depth 4332

PRODUCTION

1st 24 hrs. Nat. 1st 24 hrs. after shot Gas Cu. Ft.Dry Hole Abandoned

Date

OCT 28 1942

19

S. J. LEWIS

Scout