


Section 12 Township 27 Range 13W

Well No. #3 Beck

Company Cities Service

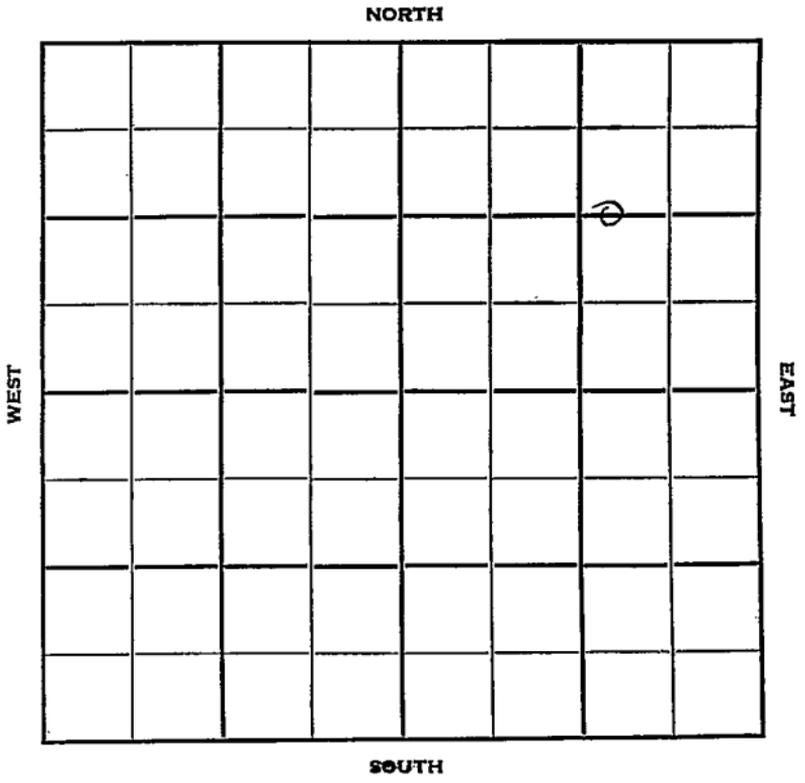

Pratt

KANSAS 13W

Sec. 12 Twp. 27 R. 13

Well No. #3 Beck Farm \_\_\_\_\_

Cities Service Company \_\_\_\_\_

Contractor \_\_\_\_\_

Iuka Pool


1320' Ft. from N. Line

\_\_\_\_\_ Ft. from S. Line

1010' Ft. from E. Line

\_\_\_\_\_ Ft. from W. Line

C W L E  $\frac{1}{2}$  NE

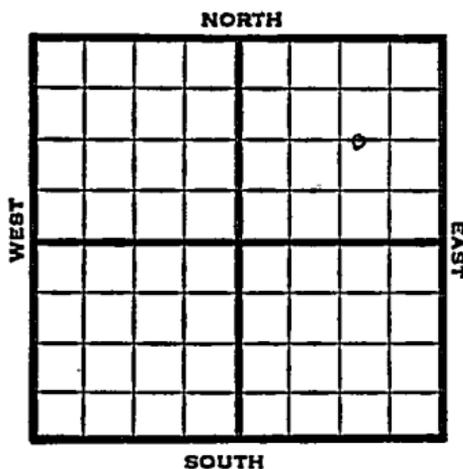

1951 Elev. 1898' REPORT

5/16

Location

7/11

Spud 5-21-51 D & A TD 4263'  
 8" @ 367' KC 3724' Miss 4093'  
 Kh 4122' Viola 4191' Simp sh 4231'  
 Simp. sd. 4240' TD 4263'  
 5" @ 4250 27 qt/ 4251-61  
 P/42 BO 4 hr. 1000 A SP 4010'  
 33/3917-25 33/3936-44 1000 A  
 P/29 BO 173 BWPD 33/3936-44  
 P/ 100% water  
 D & A

ABANDONED



County Pratt State Kansas

Sec. 12 (Blk. 27 (Sur. 13W (Twp.) (Rge.) Map No.

Operator Cities Service

Well No. 3 Farm Beck

Elev. 1898 Location C W L E $\frac{1}{2}$  NE


1320 Ft. From N Line NE

1010 Ft. From E Line Quarter

Ist. Report

Completion JUL 11 1951

Remarks Iuka Pool

Spudding Date 5-21-51

Drlg. Data D & A TD 4263

8" @ 367 KC 3724 Miss. 4093

Kh. 4122 Viola 4191 Simp. sh. 4231

Simp. sd. 4240 TD 4263 5" @ 4250

27 qt/ 4251-61 P/ 42 bo 4 hr.

1000 A SP 4010 33/ 3917-25

33/ 3936-44 1000 A P/ 29 bo

173 bwpd 33/ 3936-44 P/ 100% water

D & A