


Section 12 Township 27 Range 13W

Well No. #2 Eeck

Company Cities Service oil

Iuka Pool

NORTH

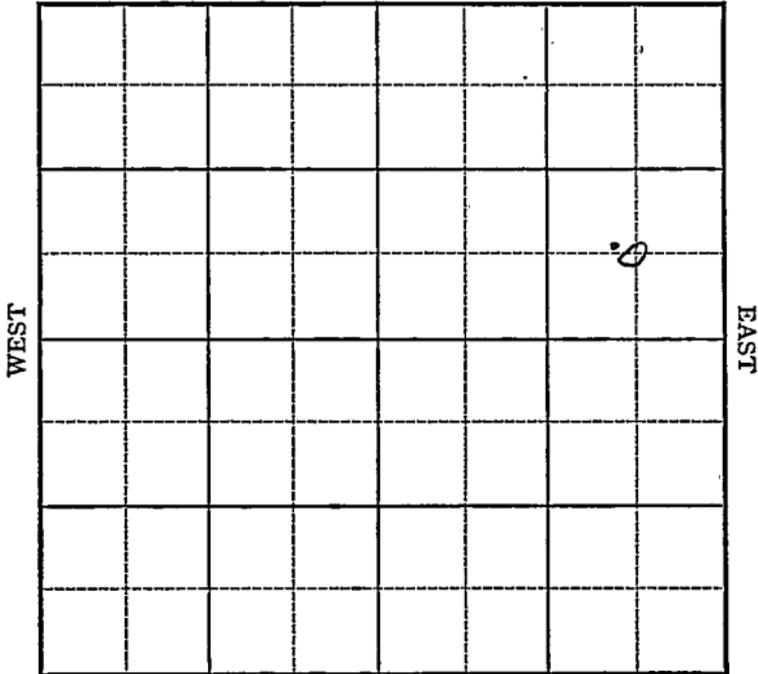

SOUTH

Sec. 12 Twp. 27 R. 13W

Well No. #2 Beck Farm \_\_\_\_\_

Cities Service Company \_\_\_\_\_

(Iuka Pool)


\_\_\_\_\_ Ft. from N. Line

660 Ft. from S. Line

660 Ft. from E. Line

\_\_\_\_\_ Ft. from W. Line

Elev. 1888

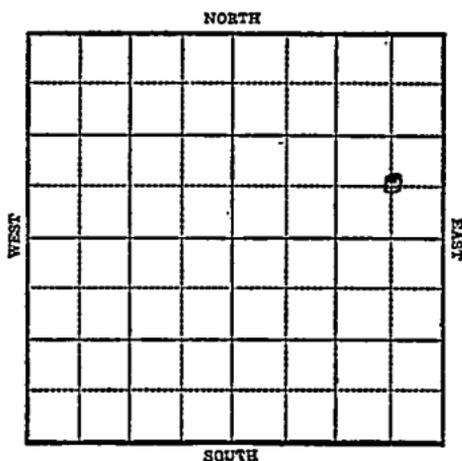

1942

R E P O R T

11/4 Location

11/11 "

11/18 "

11/24 10" @ 400  
Drlg. 500'

12/2 Drlg. 3485

12/9 Simp shale 4235  
Simp sand 4241  
Coring 4244

12/16 TD 4254  
7" @ 4244  
3850 oil in 10 hrs.

12/22 Flow 11 bbls oil per hr. 13 hrs.

12/29 1000 acid SD

1943

1/6 " " "

1/13 " " "

1/20 " " "

1/27 Viola 4192

7" @ 4244'

T.D. 4254'

Pump 227 Pot. 1000 gals. acid

Gravity 37

**COMPLETED**

**KANSAS** Pratt

Map No. 92 Sec. 12 Twp. 27 R. 13W

Well No. 2 Beck


Cities Service Oil Company

**FIRST REPORT** Contractor

C SE NE

SECTION PLAT

\_\_\_\_\_ Ft. from N. Line  
660 Ft. from S. Line  
660 Ft. from E. Line  
 \_\_\_\_\_ Ft. from W. Line

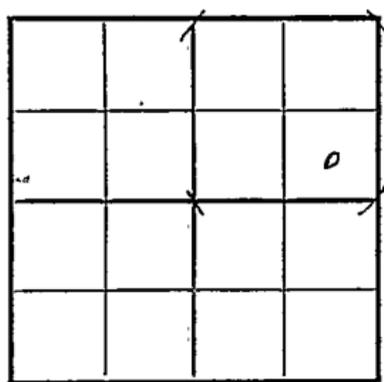

**IUKA POOL**

Location XXX  
 Rig up \_\_\_\_\_  
 Drilling and Remarks:

**RECORD**

Cased \_\_\_\_\_ in., \_\_\_\_\_ ft.  
 Sand \_\_\_\_\_  
 Gas \_\_\_\_\_  
 Oil \_\_\_\_\_  
 Total Depth \_\_\_\_\_

**PRODUCTION**

1st 24 hrs. Nat. \_\_\_\_\_  
 1st 24 hrs. after shot \_\_\_\_\_  
 Gas \_\_\_\_\_ Cu. Ft.  
 Dry Hole \_\_\_\_\_  
 Abandoned \_\_\_\_\_

Date

NOV 4 1942 19

S. J. LEWIS Scout

**KANSAS**  
 Map No. 92 Sec. 12 Twp. 27 R. 13 W

Well No. 2 Beck

Cities Service Oil Company

**COMPLETED** Contractor

C SE NE

SECTION PLAT

\_\_\_\_\_ Ft. from N. Line

660 Ft. from S. Line

660 Ft. from E. Line

\_\_\_\_\_ Ft. from W. Line

			0

IUKA POOL

Location \_\_\_\_\_

Rig up \_\_\_\_\_

Drilling and Remarks:

*Viola 4192*

*7" @ 4244*

*1000 acid*

*Pump 227 P & Y*

*370 ft*

RECORD

Cased \_\_\_\_\_ in., \_\_\_\_\_ ft.

Sand \_\_\_\_\_

Gas \_\_\_\_\_

Oil \_\_\_\_\_

Total Depth 4254

PRODUCTION

1st 24 hrs. Nat. \_\_\_\_\_

1st 24 hrs. after shot \_\_\_\_\_

Gas \_\_\_\_\_ Cu. Ft.

Dry Hole \_\_\_\_\_

Abandoned \_\_\_\_\_

Date

JAN 27 1943 19 S. I. LEWIS Scout