

Section 12 Township 27 Range 13WWell No. #4 BeckCompany Magnolia Pet.

NORTH

0							

WEST

EAST

SOUTH

Pratt

KANSAS

Sec. 12 Twp. 27 R. 13W

Well No. #4 Beck Farm

Magnolia Petr. Company

Contractor

Iuka Pool


 Ft. from N. Line

990' Ft. from S. Line

 Ft. from E. Line

330' Ft. from W. Line

NW SW NW

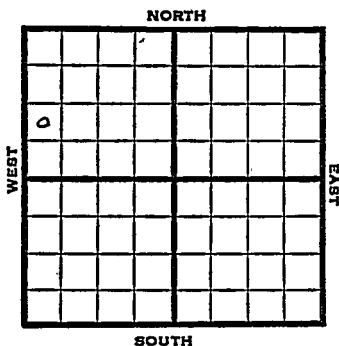

1951 Elev. 1920' REPORT

5/2 Location

6/13 Spud 5-5-51
Oil Well TD 4317
8" @ 620
Lans. 3771
DST 3926-38 opn 1 hr Rec. 15' mud
Mis 4209 Viola 4251
Simp. 4292 Sand 4298
TD 4302 5" @ 4298 DD 4315
4 goph DD 4317 25 boph Hydrafrac
4298-4317 S/3 boph
Comp. 65 bopd 7 bw

COMPLETED

County Pratt State KansasSec. 12 (Bk. Twp.) 27 (Sur. Rge.) 13W Map No.Operator Magnolia Pet.Well No. 4 Farm BeckElev. Location NW SW NW

0							

990 Ft. From S Line NW330 Ft. From W Line Quarter1st. Report MAY 2 1951

Completion

Remarks

Spudding Date

Drlg. Data Inka PoolLocation

J. E. TYRA

County Pratt State KansasSec. 12 (Blk. Twp.) 27 (Sur. Rge.) 13W Map No.Operator Magnolia Pet.Well No. 4 Farm BeckElev. 1920 Location NW SW NW

0							

990 Ft. From S Line NW330 Ft. From W Line Quarter

1st. Report

Completion JUN 13 1951Remarks Iuka PoolSpudding Date 5-5-51Drlg. Data Oil well TD 43178" @ 620 Lans. 3771 DST 3926-38open 1 hr. Rec. 15' mud Miss. 4209Viola 4251 Simp. 4292 Sand 4298TD 4302 5" @ 4298 DD 43154 goph DD 4317 25 goph Hydrofrac4298-4317 s/ 3 bophComp. 65 bopd 7 bw

J. E. TYRA