

Sec. 12 Twp. 27 R. 13-W

Well No. #3 Katie Beck Farm

Magnolia Company


(Iuka Pool)

990 Ft. from N. Line

 Ft. from S. Line

990 Ft. from E. Line

 Ft. from W. Line

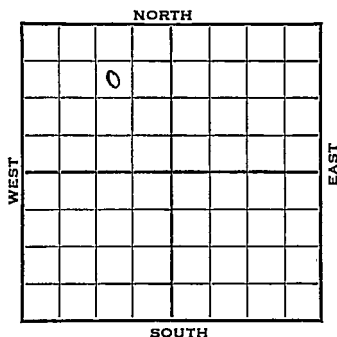

SW NE NW Elev. 1913

1942

REPORT

8/27	Location
9/2	10" - 645 Drlg. 1880
9/9	Drlg 3640
9/16	Viola 4186 fsg @ 4263
9/23	Simp 4290 T.D. 4300' 5" 4290 RUST
9/30	TD 4310 Tstg. Perf. csg 4292-96 - 12 shots Perf. csg. 4284-91 - 12 shots Treated 4000 gals - swab 3/4 bbl fluid per hour.
10/7	PB 4280 95 shots 4249-80 S.O.
10/14	Drlg 4320- 1200' fluid SSO
10/21	Drlg 4390'
10/28	Arb 4389 T.D. 4408SD
11/4	Arb 4389' Water TD 4408'

ABANDONED

Pratt

Map No. 92 Sec. 12 Twp. 27 R. 13W

Well No. 3 Katie Beck

Magnolia Company

FIRST REPORT Contractor

SW NE NW

SECTION PLAT

990 Ft. from N. Line

_____ Ft. from S. Line

990 Ft. from E. Line

_____ Ft. from W. Line

	o		

IUKA POOL

RECORD

Location XXX

Cased _____ in., _____ ft.

Rig up _____

Sand _____

Drilling and Remarks:

Gas _____

Oil _____

Total Depth _____

PRODUCTION

1st 24 hrs. Nat. _____

1st 24 hrs. after shot _____

Gas _____ Cu. Ft.

Dry Hole _____

Abandoned _____

Date

AUG 27 1942 19

S. J. LEWIS Scout

KANSAS

Map No. 92 Sec. 12 Twp. 27 R. 13W

Well No. 3 Katie Beck

Magnolia Company

ABANDONED Contractor

SW NE NW

SECTION PLAT

990 Ft. from N. Line

_____ Ft. from S. Line

990 Ft. from E. Line

_____ Ft. from W. Line

	o		

TUKA POOL

Location _____

Rig up _____

Drilling and Remarks:

*CEL 84389
Wa Test*

RECORD

Cased _____ in., _____ ft.

Sand _____

Gas _____

Oil _____

Total Depth 4408

PRODUCTION

1st 24 hrs. Nat. _____

1st 24 hrs. after shot _____

Gas _____ Cu. Ft.

Dry Hole _____

Abandoned _____

Date

NOV 4 1942 19

S. J. LEWIS Scout