

1 - 27 - 13W


WELL LOG BUREAU - KANSAS GEOLOGICAL SOCIETY
508 East Murdock Wichita, Kansas

Company - LINDSLEY DRILLING COMPANY
Farm - Helmke No. 1

SEC. 1 T. 27 S. 13W
NE SW SW

Total Depth. 4402
Comm. 8-10-51 Comp. 8-29-51
Shot or Treated.
Contractor. Lindsley Drlg Co.
Issued. 9-29-51

County. Pratt
KANSAS

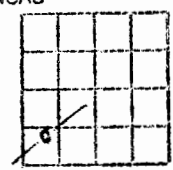

CASING:

8 5/8" 264'

Elevation. 1894 DE
1896 (sand)
Production. dry

Figures indicate Bottom of Formations.

sand	65
sand, clay	140
red bed, shells	264
cement, red bed, shells	435
red bed	620
sand, red bed	825
shale, shells	1000
shale, lime	1840
lime sandy	1950
lime, shale	2720
shale	3010
SLM @ 1500 - OK	
SLM @ 2000 - OK	
SLM @ 2500 - OK	
shale, lime	3270
Strapped drill pipe	
lime	3465
lime broken	3625
lime, shale	3730
lime	3810
lime, shale	3930
lime	4005
lime, shale	3075
lime	4117
lime, shale	4160
chert, lime	4252
sand, shale, chert	4265
chert, sand	4292
shale, lime	4402
Total Depth	
Tops:	
Lansing	3725
Mississippi	4077
Kinderhook	4118
Viola	4142
Simpson Shale	4226
Arbuckle	4338

Pratt

KANSAS

Sec. 1 Twp. 27 R. 13WWell No. #1 Helmke FarmBob Lindsley CompanyLindsley - Contr. ContractorTuka Pool


Ft. from N. Line

990' Ft. from S. Line

Ft. from E. Line

990' Ft. from W. Line

NE SW SW

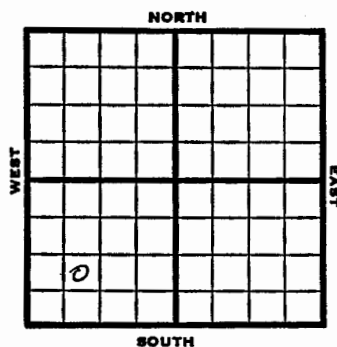

1951 Elev. 1894' REPORT

8/15 Spud 8-10-51

8" @ 264

Drlg. 1524

9/5 Spud 8-10-51

D&A TD 4399

8" @ 264

KC 3725 Miss. 4077 Kh. 4118

Viola 4142

DST 4152-77 open $\frac{1}{2}$ hr. rec. 15' GCM

Simp. 4226

DST 4238-56 open $\frac{1}{2}$ hr. rec. 600' gas

40' GCM

DST 4262-86 open 1 hr. gas in 33 min.

rec. 300' SW 15' GCM

Arb. 4338

DST 4351-81 open 45 min rec. 3100'

sulphur wtr. TD 4399

D&A

ABANDONED