
DX 78-1 O. W. D. D. Pratt

KANSAS

Section 31 Township 27 Range 13W

Well No. #3 Greenstreet

Company Sterling Drlg.

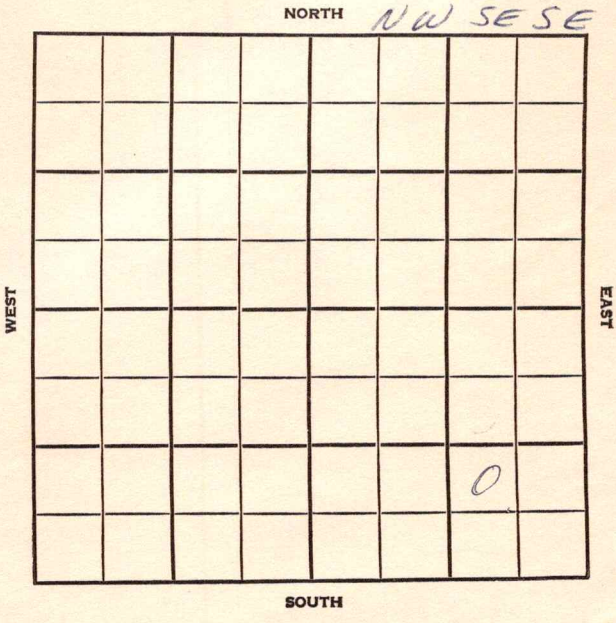

O.W.W.O.

Twp. Pool

Co. Facet

S-513-B

County Pratt Elev. 1876

Sec. 31 Twp. 27 Rge. 13W

Company Sterling Drlg.

Farm Name Greenstreet No. 3

TOPS	DEPTH	LOG	DATUM
Anh.			
Tp.			
H.			
Tr.			
Dg.			
B. L.			
L.	3791		
K.C.	4136		
B.K.C.			
Ce.	4254		
C.	4259		
M. ch.			
M.			
K.	4276		
Mz.			
Mq.			
V.	4310		
S.	4357		
S.			
A.	4473		
R.			
Pf.			
G.			
T.D.	4520		

Loc. in Sec. NW SE SE

O.W.W.O.

Geol.

Contr.

Pool Fitzsimmons

COMPLETE

AUG 20 '58

O

Date Comm.

TD 4850 5½" @ 4520 Ck to be SWD JUN 25 '58

20/4359-64 12/4371-74 Ls frac 35005d $ 15BO 225BW 8hrs to be producer in simp SWD in Arb JUL 2 '58 $ 10BO + 110 BW 6½hrs CO 4850 FU 3460 Fld mostly wtr Prod Pkr 4382 SW DW in Arb oil in simp JUL 9 '58 P Ld JUL 15 '58 JUL 23 '58 P 13BOPd + 4W + 5% JUL 30 '58 P 18BO Pd + 90 BW AUG 6 '58

Co. Lse. No. Sec. T. R.

FORM 513 SUNRAY

County Pratt Elev.

Sec. 31 Twp. 27 Rge. 13W

Company Sterling Drlg.

Farm Name Greenstreet No. 3

TOPS	DEPTH	LOG	DATUM
Anh.			
Tp.			
H.			
Tr.			
Dg.			
Bl.			
L.			
K.C.			
B.K.C.			
Ce.			
C.			
M.			
M.			
K.			
Mz.			
Mo.			
V.			
S.			
S.			
A			
R.			
P€.			
G.			
T.D.			

Loc. in Sec.
NW SE SE

Geol.

Contr.
Group Explor. Tools

Pool
Fitzsimmons



Date Comm.

Location

NOV 2 7 1956
R. C.

Co. Sec. T. R.

O.W.W.D.

S-513-B

County Pratt Elev. 1876

Sec. 31 Twp. 27 Rge. 13W

Company Sterling Drlg.

Farm Name Greenstreet No. 3

TOPS	DEPTH	LOG	DATUM
Anh.			
Tp.			
H.			
Tr.			
Dg.			
B.L.			
L.	3791		
K.C.			
B.K.C.	4136		
Ce.			
C.	4254		
M. ch.	4259		
M.			
K.	4276		
Mz.			
Mq.			
V.	4310		
S.	4357		
S.			
A.	4473		
R.			
Pf.			
G.			
T.D.	4420		

Loc. in Sec. NW SE SE

OWWO

O.W.W.D.

Geol.

Contr.

Pool Fitzsimmons

JUN 18 '58 FIRST REPORT

Date Comm. OTD 4420

DD 4850 5½" @ 4520 CO to be SWD

Co. Lse. No. Sec. T. R.

FORM 513 SUNRAY

County Pratt Elev. 1876 DF

Sec. 31 Twp. 27 Rge. 13W

Company Sterling Drlg.

Farm Greenstreet No. 3

TOPS	DEPTH	LOG	DATUM
Anh.			
Tp.			
H.	3614		
Tr.			
Dg.			
Bl.	3776		
L.	3791		
K.C.			
B.K.C.	4136		
Ce.			
C.	4254		
M. chenty	4259		
M.			
K.	4276		
Mz.			
Mo.			
V.	4310		
S.	4352		
S.			
A			
R.			
P€.			
G.			
T.D.	4420		

Loc. in Sec. NW SE SE

Geol.

Contr. Group Explor. Tools #4

Pool Fitzsimmons So

ABANDONED NOV 23 '56

1/4 mile

Co. Lse. No. Sec. T. R.

Date Comm.

Location OCT 31 '56 Spd 10-27-56

8 5/8 360/250 ϕ 1470 DST

3950-85 1hr 300' gas # 75'

OCGCM BHP 580 NOV 13 '56

DST 3985-4030 1hr 210' SW BHP?

DST ~~4085~~-30 DST 4076-4111 op 90"

15' Md BHP? DST 4292-4360 1hr

60' Md +60' 955# Md BHP? DST

4354-4420 1hr 125' OCM +540' SOC 955#

wtr BHP 1224/30" DST 4354-77

FORM 513-1 SUNRAY

2 hrs 1100' OCM & W + 210' Md
300' MW + 610' clear wtr (50c)
440' gas FP 75 - 490 BHP
1240/30" NOV 21 '56

D & A (hold)

Back core 4360-4420 Full rec
(4360-63 Dolo. Fair sh. oil 4365-67
sd satur. sd 2n 4385-92 S.O. Tite
sd 4400-08 S.O. sd 4408-20
Silty N.S.

Complete

31-27-13 mw dl dl

FORM 513-1 SUNRAY

AUG 13 '58 AUG 20 '58

W o pot

Phy P 1880 pd + 1990 w

Simp 4359-64 and
4371-74

SW Disposal in Arb

31-27-13W NW ¼ ¼