

KANSAS


Pratt

FORM 51 5M 10-41 PETROL

Section 11 Township 27 Range 13-W

Well No. #2 Luders

Company Atlantic et al

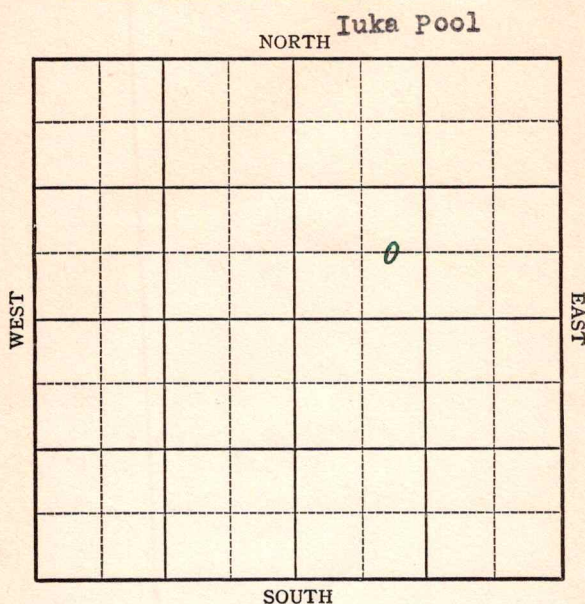

O.W.D.D.

**KANSAS**

Pratt

Sec. 11 Twp. 27 R. 13-W

Well No. #2 Luders Farm

Atlantic etal.

Company

(Iuke)


         Ft. from N. Line

660 Ft. from S. Line

         Ft. from E. Line

990 Ft. from W. Line

*W. 1922*

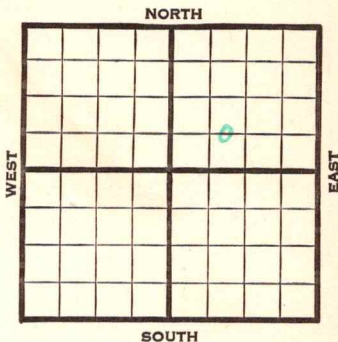

|       |                                     |
|-------|-------------------------------------|
| 1941  | REPORT <b>O. W. D. D.</b>           |
| 12/17 | Location                            |
| 12/24 | "                                   |
| 12/31 | 8" - 377' WOC.                      |
| 1942  |                                     |
| 1/8   | Anhy 727' Ft. Riley 2125'           |
|       | Drlg. 2430'                         |
| 1/15  | Drlg. 3650'                         |
| 1/22  | Lans. 3786' Drlg. 4050'             |
|       |                                     |
| 1/28  | <b>Simpson 4288'</b>                |
|       | T.D. 4289'                          |
|       | S.S.O. Plugged off Simpson.         |
|       | Will let set until the War is over. |
|       |                                     |
|       | <b>ABANDONED</b>                    |
|       |                                     |
| 1942  | <b>O. W. D. D.</b>                  |
| 2/25  | <b>Simpson 4288'</b>                |
|       | T.D. 4303' C.O. to run pipe.        |
| 3/5   | 5" - 4300' WOC.                     |
|       |                                     |
|       | <b>OVER</b>                         |

1942

3/12

T.D. 4311' 3000 acid.

Swab 5 oil per hour.

3/18

Simpson 4288'

5" - 4300'

T.D. 4311'

3000 acid.

Potential 377 bbls., pump.

37. Gravity

COMPLETED

Map No. 92 Sec. 11 Twp. 27 R. 13WWell No. 2 LudersAtlantic etal. CompanyCOMPLETED Contractor

C E L S W N E

## SECTION PLAT

|  |  |  |  |
|--|--|--|--|
|  |  |  |  |
|  |  |  |  |
|  |  |  |  |
|  |  |  |  |
|  |  |  |  |
|  |  |  |  |

         Ft. from N. Line660 Ft. from S. Line         Ft. from E. Line990 Ft. from W. Line

IUKA POOL

## RECORD

Location                         Cased          in.,          ft.Rig up                         Sand                         

Drilling and Remarks:

Gas                         Oil                         Total Depth 4311                                                                

## PRODUCTION

1st 24 hrs. Nat.                         1st 24 hrs. after shot                         Gas                          Cu. Ft.Dry Hole                         Abandoned                         

Date

MAR 1 8 1942 19S. J. LEWIS Scout

Pratt

KANSAS

Map No. 92 Sec. 11 Twp. 27 R. 13WWell No. 2 LudersAtlantic etal. Company

Contractor

## FIRST REPORT

C EL SW NE

         Ft. from N. Line660 Ft. from S. Line         Ft. from E. Line990 Ft. from W. Line

## SECTION PLAT

|  |  |   |  |
|--|--|---|--|
|  |  |   |  |
|  |  | o |  |
|  |  |   |  |
|  |  |   |  |

## IUKA POOL

Location XXRig up         

Drilling and Remarks:

## RECORD

Cased          in.,          ft.Sand         Gas         Oil         Total Depth         

## PRODUCTION

1st 24 hrs. Nat.         1st 24 hrs. after shot         Gas          Cu. Ft.Dry Hole         Abandoned         

Date

DEC 17 1941

19

S. J. LEWIS

Scout

Map No. 92 Sec. 11 Twp. 27 R. 13WWell No. 2 LudersAtlantic etal.


Company

ABANDONED

Contractor

C E L S W N E

SECTION PLAT

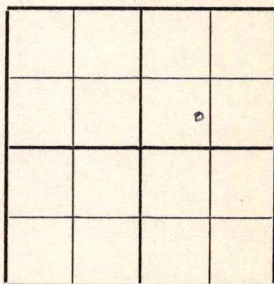         Ft. from N. Line660 Ft. from S. Line         Ft. from E. Line990 Ft. from W. Line

IUKA POOL

Location                                 Rig up                                 

Drilling and Remarks:

*Simpson #288.  
SSO. Plugged off  
Simpson will be  
let until the  
war is over*

## RECORD

Cased          in.,          ft.Sand                                 Gas                                 Oil                                 Total Depth 4289

## PRODUCTION

1st 24 hrs. Nat.                                 1st 24 hrs. after shot                                 Gas                                  Cu. Ft.Dry Hole                                 Abandoned                                 

Date

JAN 28 1942 19S. J. LEWIS

Scout

Pratt

KANSAS

Map No. 92 Sec. 11 Twp. 27 R. 13WWell No. 2 LudersAtlantic etal.

Company

FIRST REPORT

Contractor

C EL SW NE

## SECTION PLAT

|  |  |   |  |
|--|--|---|--|
|  |  |   |  |
|  |  | 0 |  |
|  |  |   |  |
|  |  |   |  |

       Ft. from N. Line660 Ft. from S. Line       Ft. from E. Line990 Ft. from W. Line

IUKA

Location                     Rig up O.W.D.D.

Drilling and Remarks:

T.D. 4303'

Simpson 4288'

C.O. to run

Pipe

## RECORD

Cased        in.,        ft.Sand                     Gas                     Oil                     Total Depth                     

## PRODUCTION

1st 24 hrs. Nat.                     1st 24 hrs. after shot                     Gas                      Cu. Ft.Dry Hole                     Abandoned                     

Date

FEB 25 1942

19

S. J. LEWIS

Scout