

KANSAS

Pratt

Sec. 11 Twp. 27 R. 13-W

Well No. #1 Tritsch Farm

Atlantic Production Company

(Iuka)


660 Ft. from N. Line

 Ft. from S. Line

 Ft. from E. Line

660
330 Ft. from W. Line

Elw. 1913

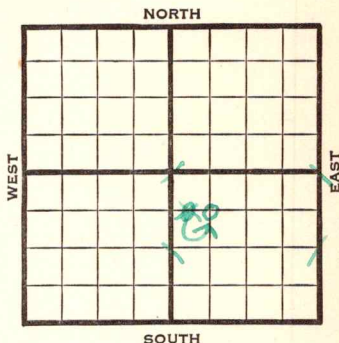

1942	REPORT
6/17	Surface hole 80'
6/24	Anhy. 682' Drlg. 2735'
7/1	Lans. 3769' Viola 4212'
	Drlg. 4215'
7/8	Simp. Sand 4302' 5" - 4303'
	T.D. 4314' S.O. & W.
7/15	" " "
7/22	" " "
7/29	Simp. sd 4302'
	5" - 4303'
	1500 acid
	T.D. 4314'
	Pump 831 Pot.
	Gravity 37.
	COMPLETED

KANSAS

Pratt

Map No. 92 Sec. 11 Twp. 27 R. 13WWell No. 1 TritschAtlantic Production Company**FIRST REPORT**

Contractor

C WL NW SE

SECTION PLAT

		0	

660 Ft. from N. Line Ft. from S. Line Ft. from E. Line330 Ft. from W. Line

IUKA POOL

Location Rig up

Drilling and Remarks:

Surface Hole 80

RECORD

Cased in., ft.Sand Gas Oil Total Depth

PRODUCTION

1st 24 hrs. Nat. 1st 24 hrs. after shot Gas Cu. Ft.Dry Hole Abandoned

Date

JUN 17 1942

19

S. J. LEWIS

Scout

Pratt

KANSAS

Map No. 92 Sec. 11 Twp. 27 R. 13WWell No. 1 Tritsch

Atlantic Production

Company

CORRECTION

Contractor

C NW SE

SECTION PLAT

		0	

660 Ft. from N. Line Ft. from S. Line Ft. from E. Line660 Ft. from W. Line

IUKA POOL

Location Rig up

Drilling and Remarks:

Reported

C W L NW SE

RECORD

Cased in., ft.Sand Gas Oil Total Depth

PRODUCTION

1st 24 hrs. Nat. 1st 24 hrs. after shot Gas Cu. Ft.Dry Hole Abandoned

Date

S. J. LEWIS

JUN 26 1942 19

Scout

KANSAS

Pratt

Map No. 92 Sec. 11 Twp. 27 R. 13WWell No. 1 TritschAtlantic Production CompanyCOMPLETED Contractor

C NW SE

660 Ft. from N. Line Ft. from S. Line Ft. from E. Line660 Ft. from W. Line

SECTION PLAT

		o	

IUKA POOL

Location Rig up

Drilling and Remarks:

*Surf. Sal 4302**5" @ 4303**1500 acid**Pump 831 P & Y**37 = Gr*

RECORD

Cased in., ft.Sand Gas Oil Total Depth 4314

PRODUCTION

1st 24 hrs. Nat. 1st 24 hrs. after shot Gas Cu. Ft.Dry Hole Abandoned

Date

JUL 29 1942 19S. J. LEWIS Scout