


Section 11 Township 27 Range 13W

Well No. #1 Luders

Company Jackson & Lindsley

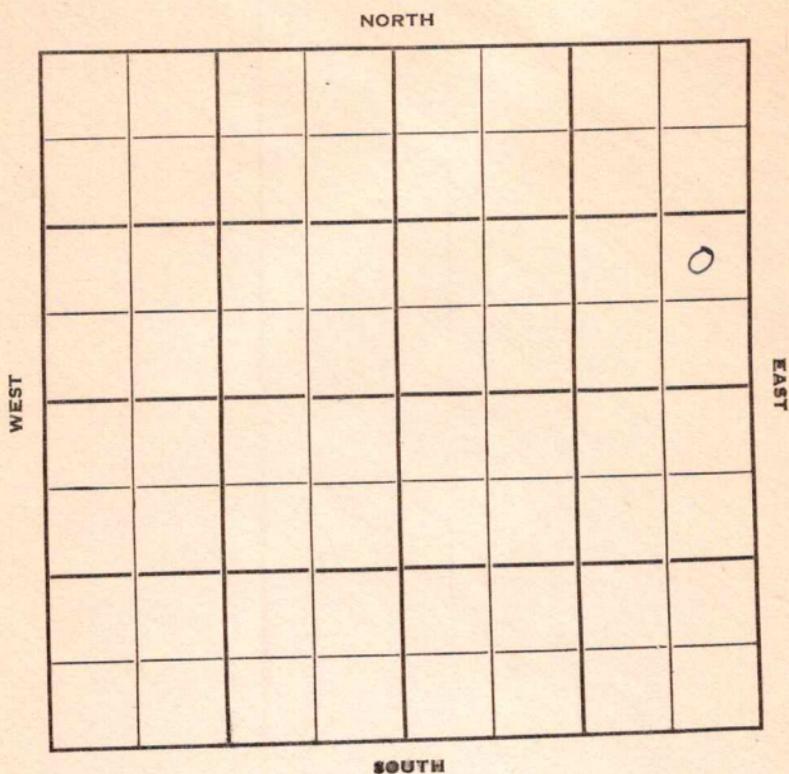

Pratt

KANSAS ✓

Sec. 11 Twp. 27 R. 13W

Well No. #1 Luders Farm

Jackson & Lindsley Company

Jackson - Lindsley Contractor

Carmi Pool


\_\_\_\_\_ Ft. from N. Line

990' Ft. from S. Line

330' Ft. from E. Line

\_\_\_\_\_ Ft. from W. Line

NE SE NE

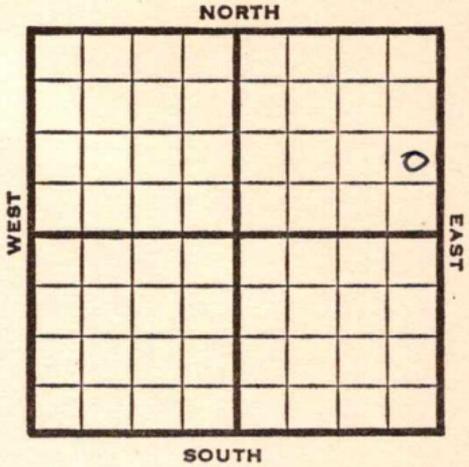

1950

**Elev 1918** REPORT

9/13

Location

11/1

Spud 9-15-50  
 8 5/8" @ 249  
**Anhy 685**  
**Br lime 3756**  
**Lans 3773**  
**Viola 4219**  
**Simp 4297**  
**Sand 4304**  
 TD 4317  
 5" @ 4304  
 FU 400' oil 5 hr S/6 boph  
 Comp 60 bopd  
 Completed

**COMPLETED**

County Pratt State Kansas

Sec. 11 (Blk. 27) (Sur. 13W) (Twp. 0) (Rge. 13W) Map No.

Operator Jackson & Lindsley

Well No. 1 Farm Luders

Elev. \_\_\_\_\_ Location NE SE NE


990 Ft. From S Line NE

330 Ft. From E Line Quarter

1st. Report SEP 13 1950

Completion \_\_\_\_\_

Remarks \_\_\_\_\_

Spudding Date \_\_\_\_\_

Drlg. Data Carmi Pool

Location

