


KANSAS

Section 11 Township 27 Range 13W

Well No. 1 Tritsch

Company Atlantic
IUKA POOL

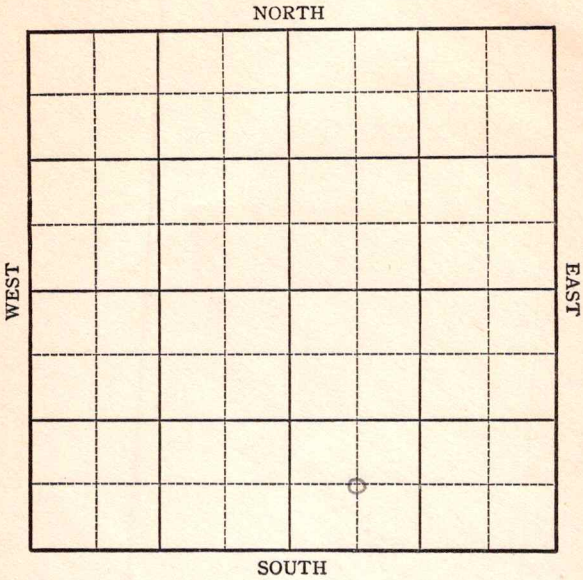

Sec. 11 Twp. 27 R. 13-W

Well No. #1 Tritsch Farm

Atlantic Company

(Iuka Pool)


 Ft. from N. Line

660 Ft. from S. Line

 Ft. from E. Line

660 Ft. from W. Line

Elev. 1923'

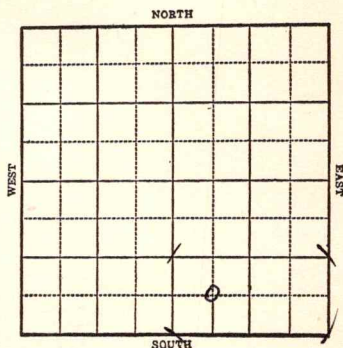

1942

R E P O R T

10/14 8" - 375'
Waiting on Cement.

10/21 Drlg 2975'

10/28 Anhy 725
Mr. Riley 2140
Drlg 4180

11/4 Lans 2779
Viola 4226
Simp sat 4331
SD
TD 4336
5" @ 4331 Rust

11/11 " "

11/18 " " "

11/24 swb 4½ water per hr SD

12/2 " " "

12/9 T drill deeper

12/16 " "

12/22 " "

12/29 1 qt shot 4335-46
pipe collapsed

1943


1/6 Simp. sd 4331 5" - 4331 water
T.D. 4337

ABANDONED

KANSAS
Map No. 742 Sec. 11 Twp. 27 R. 13WWell No. 1 TritschAtlantic CompanyABANDONED Contractor

C SW SE

SECTION PLAT

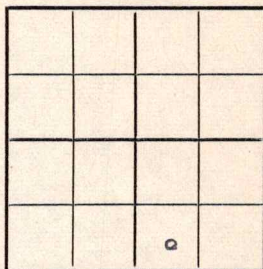 Ft. from N. Line660 Ft. from S. Line Ft. from E. Line660 Ft. from W. Line

IUKA POOL

Location Rig up

Drilling and Remarks:

Imp. Sol 4331
5" @ 4331
Water.

RECORD

Cased in., ft.Sand Gas Oil Total Depth 4337

PRODUCTION

1st 24 hrs. Nat. 1st 24 hrs. after shot Gas Cu. Ft.Dry Hole Abandoned

Date

JAN 6 1943 19S. J. LEWIS Scout

Map No. 92 Sec. 11 Twp. 27 R. 13WWell No. 1 TritschAtlantic


Company

FIRST REPORT

Contractor

C SW SE

SECTION PLAT

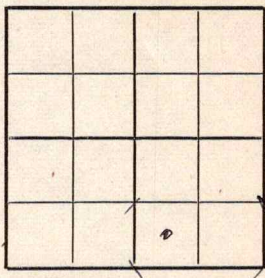

_____ Ft. from N. Line

660 Ft. from S. Line

_____ Ft. from E. Line

660 Ft. from W. Line

IUKA POOL

Location _____

Rig up _____

Drilling and Remarks:

8"-375'Waiting on
Cement

RECORD

Cased _____ in., _____ ft.

Sand _____

Gas _____

Oil _____

Total Depth _____

PRODUCTION

1st 24 hrs. Nat. _____

1st 24 hrs. after shot _____

Gas _____ Cu. Ft.

Dry Hole _____

Abandoned _____

Date

OCT 14 194219S. J. LEWIS

Scout