

O.W.W.O.

Pratt

KANSAS

Section 13 Township 27 Range 13 W

Well No. # 1 Montgomery

Company K & E Drilling

NORTH

WEST

EAST

|  |  |  |   |  |  |  |  |
|--|--|--|---|--|--|--|--|
|  |  |  |   |  |  |  |  |
|  |  |  |   |  |  |  |  |
|  |  |  |   |  |  |  |  |
|  |  |  |   |  |  |  |  |
|  |  |  | 0 |  |  |  |  |
|  |  |  |   |  |  |  |  |
|  |  |  |   |  |  |  |  |
|  |  |  |   |  |  |  |  |

SOUTH

O.W.W.O.

Pratt

KANSAS ✓✓

Sec. 13 Twp. 27 R. 13 W

Well No. # 1 Montgomery Farm

K &amp; E Drilling Company

K &amp; E Drlg. Contractor


330 Ft. from N. Line

Ft. from S. Line

330 Ft. from E. Line

Ft. from W. Line

NE NE SW

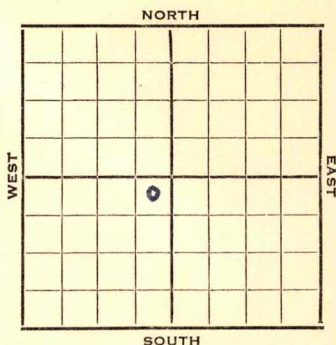

1952

Elev. 1901'

REPORT

9/17

Spud 9-13-52

8" @ 270 Anhy 679'

Drlg. 1576'

9/24

Drlg. 3850

10/1

Tite Hole, taking DST in Simp.

10/8

Spud 9-13-52

D &amp; A TD 4362' 8" @ 270

Anhy 679' Viola 4238' Simp sh 4291'

Dol. 4296'

DST 4296-4344 open 1 hr. rec 72' mud

TD 4362' D &amp; A

ABANDONED

O.W.W.O.

1953

9/23

Lans 3748, Viola 4238, Simp sh.

4291, Simp Dol 4296

OTD 4362

To set pipe &amp; hydro.

9/30

CO

OVER

1953

#1 Montgomery

10/14 D & A  
TD 4363'  
Lans 3748, Viola 4238, Simp sh 4291  
Simp. dol. 4296  
OTD 4362'  
5" @ 4363'  
CO to 4345'  
35/ 4335-39 Hydro. 20 bo 65 bw.  
16 hr. 114/ 4305-25 sd-frac  
S/ 2 bfph 10% oil  
D & A

**ABANDONED**

County **Pratt** State **Kansas**  
Sec. **13** (Blk.) **27** (Sur.) **13W** Map No.  
Operator **K & E Drilling**  
Well No. **1** Farm **Montgomery**  
Elev. Location **NE NE SW**

|  |  |  |  |  |  |  |  |  |  |
|--|--|--|--|--|--|--|--|--|--|
|  |  |  |  |  |  |  |  |  |  |
|  |  |  |  |  |  |  |  |  |  |
**FIRST REPORT**

**330** Ft. From **N** Line **SW**  
**330** Ft. From **E** Line Quarter  
1st. Report **SEP 17 1952**

Completion

Remarks

**K & E Drlg. - Contr.**


Spudding Date **9-13-52**

Drlg. Data

**8" @ 270 Anhy 679 Drlg. 1576**

**J. G. McGEHEE**

County Pratt State Kansas  
 Sec. 13 (Blk.  
Twp.) 27 (Sur.  
Rge.) 13W Map No.  
 Operator K & E Drlg.  
 Well No. 1 Farm Montgomery  
 Elev. 1901 Location NE NE SW

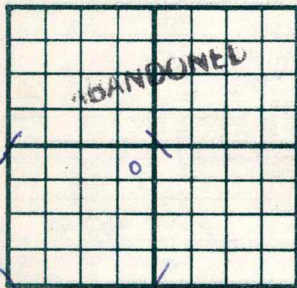

330 Ft. From N Line SW  
330 Ft. From E Line Quarter

1st. Report

Completion OCT 8 1952

Remarks

K & E Drlg. - Contr.

Spudding Date 9-13-52

Drlg. Data D & A TD 4362

8" @ 270 Anhy 679 Viola 4238

Simp. sh. 4291 Dol. 4296 DST 4296-4344

open 1 hr. Rec. 72' mud TD 4362

D & A

J. G. McGEHEE

O.W.W.O.

County Pratt State Kansas

Sec. 13 (Blk. Twp.) 27 (Sur. Rge.) 13W Map No.

Operator K &amp; E Drlg.

Well No. 1 Farm Montgomery

Elev. 1901 Location NE NE SW



330 Ft. From N Line SW

330 Ft. From E Line Quarter

1st. Report

Completion OCT 14 1953

Remarks OWWO

Spudding Date

Drlg. Data D &amp; A TD 4363

Lans. 3748 Viola 4238 Simp. sh. 4291

Simp. dol. 4296 OTD 4362 5" @ 4363

CO to 4345 35/ 4335-39 Hydro. 20 bo

65 bw 16 hr. 114/ 4305-25 sd-frac

S/ 2 bfph 10% oil

D &amp; A

J. G. McGEHEE