


Section 14 Township 27 Range 13-W

Well No. #1 Rolf

Company Atlantic

Iuka Pool

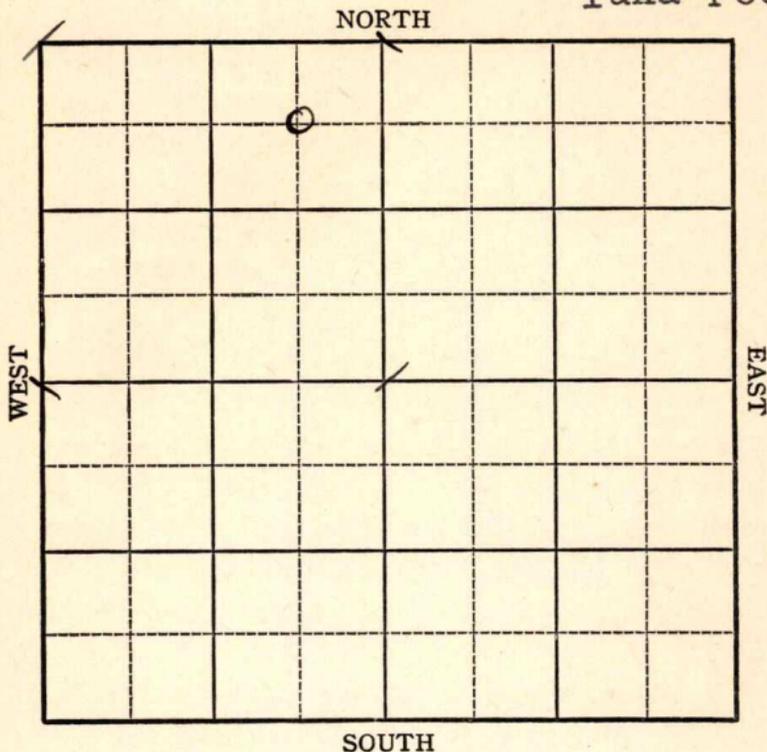

Sec. 14 Twp. 27 R. 13-W

Well No. #1 Rolf Farm

Atlantic Company

(Iuka Pool)


660 Ft. from N. Line

Ft. from S. Line

660 Ft. from E. Line

Ft. from W. Line

Elev. 1936

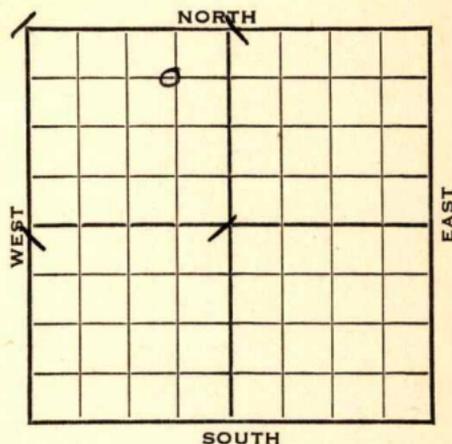

1942

REPORT

7/22 Location

7/29 8" - 359 Drlg. 1300'

8/5 Drlg. 3865'

8/12 Lans 3815 TD 3952 twist off
drill pipe to set Whipstock.

8/19 **Whipstock at 3058'**
Drlg. 3555

8/27 Drlg 4210

9/2 **Viola 4239 Simp. Sd 4350**
5" - 4300 T.D. 4355
2700' oil 12 hrs.

9/9 " " "

9/16 " " "

9/23 " " "

9/30 **Lansing 3815**
Viola 4239
Simp. Sh. 4340
Simp. Sd. 4350
5" 4350
TD 4355
2000 acid
Pump 264 bopd plus 15% wtr.
37 grav.

COMPLETED

Pratt

KANSAS

Map No. 92 Sec. 14 Twp. 27 R. 13W

Well No. 1 Rolf

Atlantic

Company

FIRST REPORT

Contractor

C NE NW


SECTION PLAT

660 Ft. from N. Line

_____ Ft. from S. Line

660 Ft. from E. Line

_____ Ft. from W. Line

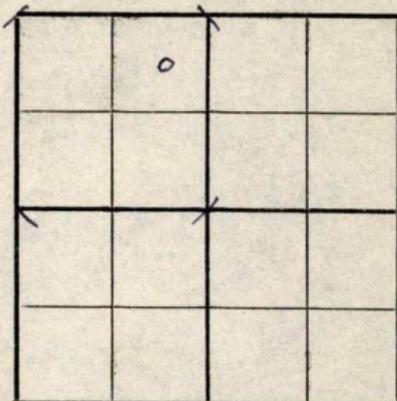

IUKA POOL

Location XXX

Rig up _____

Drilling and Remarks:

RECORD

Cased _____ in., _____ ft.

Sand _____

Gas _____

Oil _____

Total Depth _____

PRODUCTION

1st 24 hrs. Nat. _____

1st 24 hrs. after shot _____

Gas _____ Cu. Ft.

Dry Hole _____

Abandoned _____

Date

JUL 22 1942

19

S. J. LEWIS

Scout

Pratt

Map No. 92 Sec. 14 Twp. 27 R. 13W

Well No. 1 Rolf

Atlantic

Company

Contractor

C NE NW

SECTION PLAT

	o		

660 Ft. from N. Line

_____ Ft. from S. Line

660 Ft. from E. Line

_____ Ft. from W. Line

IUKA POOL

Location _____

Rig up _____

Drilling and Remarks:

2000 Acid

Pump 264 Bopd
Plus 15% wtr

37 grav

RECORD

Cased 5 in., 4350 ft.

Sand _____

Gas _____

Oil _____

Total Depth 4355

PRODUCTION

1st 24 hrs. Nat. _____

1st 24 hrs. after shot _____

Gas _____ Cu. Ft.

Dry Hole _____

Abandoned _____

Date **COMPLETED**

SEP 30 1942

19

S. J. LEWIS

Scout

Lansing 3815
 Viold 4239
 Simp. sh. 4340
 Simp. sd. 4350

Misc. Small Maps
 Cards
 Tracing
 France Map
 Scarborough Map
 Moody Map
 Geological Dept.
 Moody Flat Book

Y
 G
 R
 Y
 G
 R