


Section 19 Township 27 Range 13 W

Well No. # 1 C. E. Hetrick

Company Texas Company

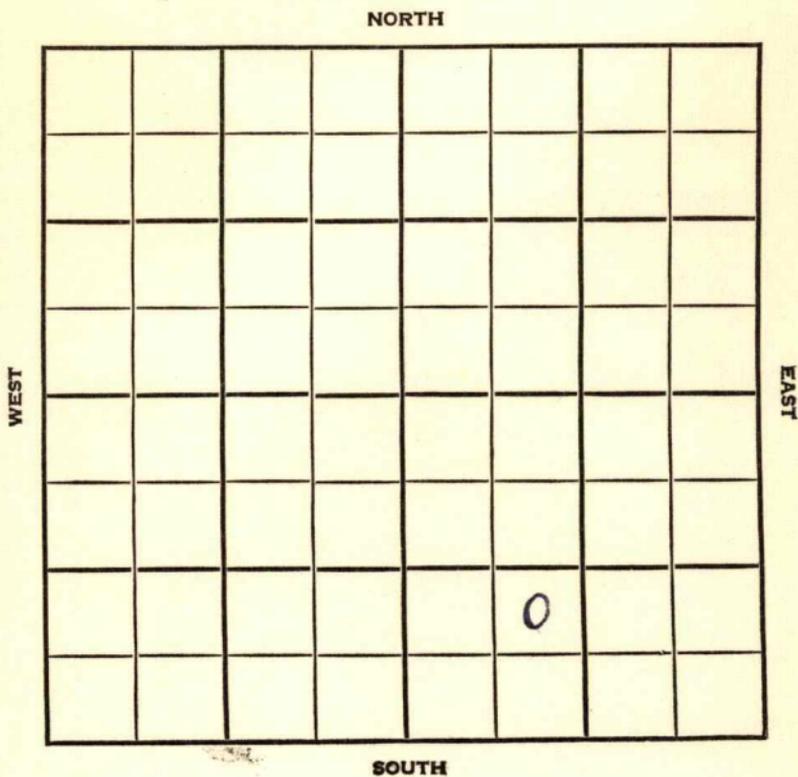

Pratt **KANSAS**

SEC. 19 TWP. 27 R. 13W

WELL NO. 1 C. E. Hetrick FARM

COMPANY Texas Co.

CONTRACTOR Stickle


Fitzsimmons Pool

_____ Ft. from N. Line

990 _____ Ft. from S. Line

_____ Ft. from E. Line

990 _____ Ft. from W. Line

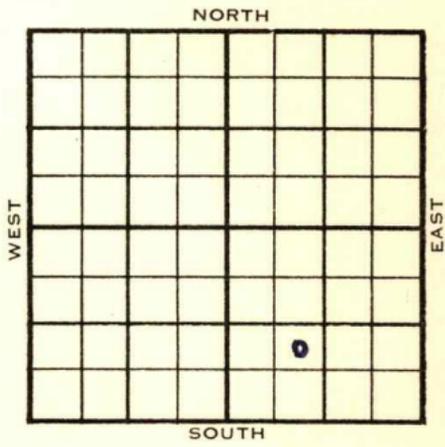

NE SW SE

1955 ELEVATION **1933'** REPORT

2/16 Spud 2-9-55
10" @ 826'
Drlg. 1875'

3/16 Spud 2-9-55 D&A, TD 4144
10" @ 826, **Heeb 3678, Br Lime 3829.** DST 3874-85, open 1 1/2 hr. Rec. 80' gas 40' SOCM ~~1300~~
1300# TD 4144, **Lans 3850,**
7" @ 4135, CO to 4144, 15 GW 1 hr 500 A 7 GO 76 GW 1 hr PB 4120 24/4100-06, 26 GO, 262 GW 3 hr. CO to 4144, S/26 GO 188 G W 3 hr. 24/4090-96, 5 GWPH 2 hr 2000 A PB 4043, 24/4008-14, 12 1/2 GWPH 500 A PB 3916 40/3880-90 11 GWPH 1000A S/18 BW 2 hr D&A

ABANDONED

