


Section 24 Township 27 Range 13WWell No. #1 McQuireCompany G-M-R Oil

NORTH

WEST

EAST

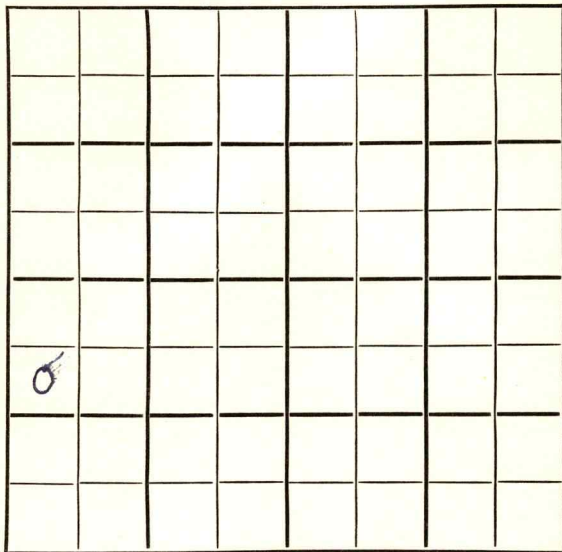

SOUTH

KANSAS ✓

Sec. 24 Twp. 27 R. 13WWell No. #1 McGuire FarmG-M-R Oil CompanyG-M-R Contractor

Wildcat.


990 Ft. from N. Line

Ft. from S. Line

Ft. from E. Line

330 Ft. from W. Line

SW NW SW

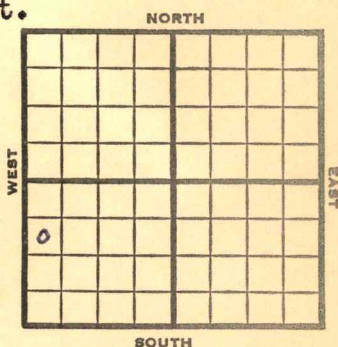

1953 Elev. 1911' REPORT

7/29 Spud 7-24-53

8" @ 267'

Anhy 699'

Drlg 2025'

8/5 Heeb 3550, Tor 3571, Doug 3624, Br. L. 3763, Lans 3784

DST 3935-48 1 hr, 30' M 460#

DST 4048-85 1 hr, 30' M 360#

Miss. L. 4171,

Drlg 4186'.

8/12 Spud 7-24-53

D&A

TD 4455

8" @ 267'

Anhy 699, Heeb 3550, Tor 3571, Doug 3624, Br lime 3763, Lans 3784

DST 3935-48, opn 1 hr., rec. 30' mud, 460#

DST 4048-85, opn 1hr., rec. 30' mud, 360#

Miss 4171

DST 4170-4216, opn 1hr., rec. 30' mud 660#

Viola 4262, Simp 4313

DST 4310-45, opn 1 hr., rec. 30' mud

Off

TD 4455

D&A

ABANDONED

Sec. 24 (Blk. Twp.) 27 (Sur. Rge.) 13W Map No.

Well No. 1 Farm McGuire

330 Ft. From W. Line Quarter

Completion

Remarks	Wildcat
---------	---------

G-M-R - Contr.

Spudding Date 7-24-53

8" @ 267 Anhy 699 Heeb. 3550

Tor. 3571 Doug. 3624 Br. lime 3763

Lans. 3784 DST 3935-48 open 1 hr.

Rec. 30' mud 460# DST 4048-85

open 1 hr. Rec. 30' mud 360#

Miss. 4171 DST 4170-4216 open 1 hr.

Rec. 30' mud 660# Viola 4262

Simp. 4313 DST 4310-45 open 1 hr.

Rec. 30' mud 0# TD 4455

D & A

J. G. McEHEE

J. G. McGEHEE