


DX 78-1 Pratt

KANSAS

Section 25 Township 27S Range 13W

Well No. #1 Grier

Company Tom Palmer Oil Co

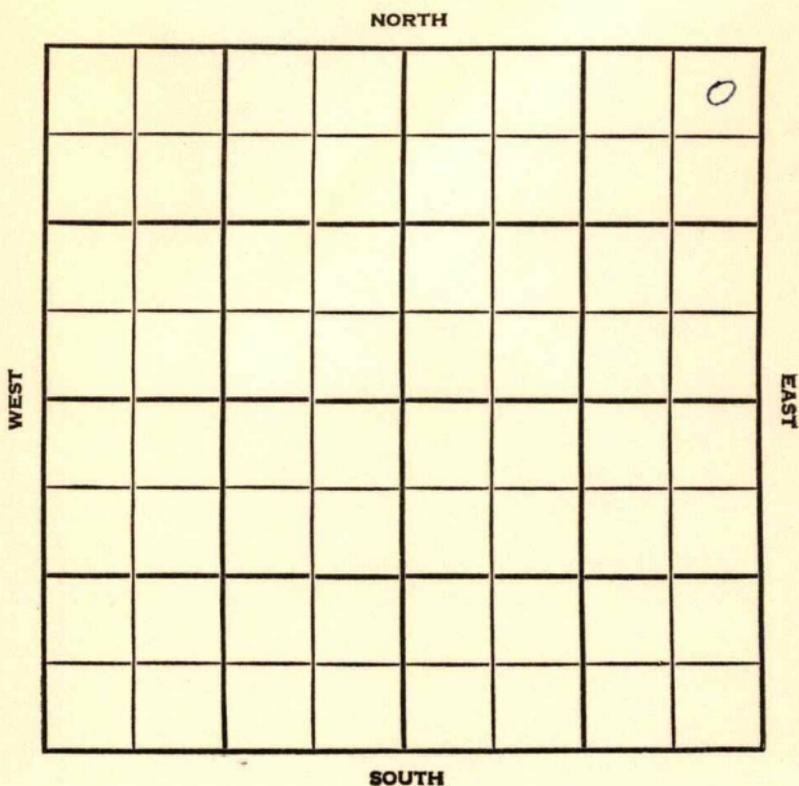

Pratt

KANSAS

SEC. 25	TWP. 27	R. 13W
------------	------------	-----------

WELL NO.

#1 Grier

FARM

COMPANY

Tom Palmer Oil Co.

CONTRACTOR

Carl Todd

Iuki-Carmi-Out Post


_____ FT. FROM N. LINE

_____ FT. FROM S. LINE

_____ FT. FROM E. LINE

_____ FT. FROM W. LINE

NE NE NE

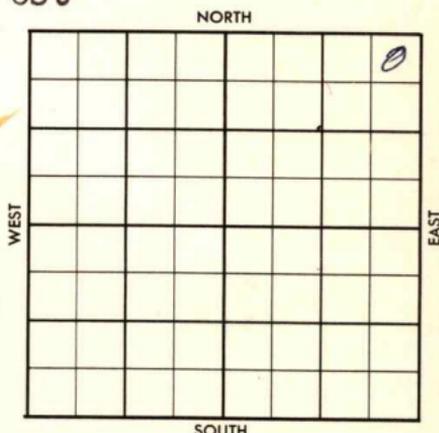

Amerada - DHM

1956	ELEVATION	REPORT
------	-----------	--------

8-29

Comm. 8-27-56
10" @ 320 w/250
WOC

County Pratt Elev. _____
 Sec. 25 Twp. 27S Rge. 13W
 Company Tom Palmer Oil Co.
 Farm Name Grier No. 1

TOPS	DEPTH	LOG	DATUM	Loc. in Sec.																
Anh.				NE NE NE																
TP.				DS * NE/4																
H.				Amerada DHM																
Tr.				Geol. _____																
Dg.				Contr. <u>Carl</u>																
Bl.				<u>Todd #1</u>																
L.				Pool <u>Iuki-Carmi</u>																
M.C.				<u>Out-Post</u>																
B.K.C.				<table border="1"> <tr> <td></td> <td></td> <td></td> <td></td> </tr> <tr> <td colspan="4" style="text-align: center;">FIRST REPORT</td> </tr> <tr> <td></td> <td></td> <td></td> <td></td> </tr> <tr> <td colspan="4" style="text-align: center;">AUG 29 '56</td> </tr> </table>					FIRST REPORT								AUG 29 '56			
FIRST REPORT																				
AUG 29 '56																				
Ce.																				
C.																				
M.																				
M.																				
K.																				
Mz.																				
Me.																				
V.																				
S.																				
S.																				
A.																				
R.																				
PE.																				
G.																				
T.D.																				

Date Comm. 8-27-56
10" 320 w/250; WOC

76

County Pratt Elev. 1903
 Sec. 25 Twp. 27S Rge. 13W
 Company Tom Palmer Oil Co.
 Farm Name Grier No. 1

TOPS	DEPTH	LOG	DATUM	Loc. in Sec.
Anh.	700			NE NE NE
TP.				DS * NE/L
H.	3571			Amerada DHM
Tr.				Geol.
Dg.				Contr. Carl
BL.	3748			Todd #1
L.	3768			Pool Iuki-Carmel
K.C.				Out-Post
B.K.C.	4111			
Ce.				
C.				
M.	4200			
M.				
K.	4216			
Mz.				
Mo.				
V.	4257			
S.	only data 4322			
S.	56 4348			
A.	4437			
R.				
PE.				
G.				
FD.	4463			ABANDONED

Date Comm. 8-27-56

10" 320 w/250; WOC SEP 5 '56 @ 3875

ord 4325-75 rec 27' DST

4332-75 1hr rec 2820' HG

C & S OCMU FP 485-1355 BHP

1510 @ ahead SEP 19 '56 DST 4328

-63 op 1hr G/70" 30' 9554

Md + 60' O & GCM + 120' 0.17 + 120' 0.14 w/

+ 180' SW BHP 1530/20" DST

4314-40 1hr G/30" TSTM rec

290' GSSY & Mdy oil BHP 1305
 120" 5 1/2 @ 4463 co 28/4329
 -36 \$ 2 Boph nolw nat.
~~1~~ SEP 26 '56 \$ to Boph 1/4
 \$ 3 Boph ~~1/2~~ \$ 98% wth
 509. OCT 3 '56 1/2 \$ 10 Boph
 nolw 1/5 90% wth
 Dock 50 Pop P. 27 B0
 + 6 Bw in 24 hrs OCT 10 '56 P.
 15 To 18 Bopd + 1 To 2
 Bw OCT 17 '56 OCT 24 '56 PF 4349-59
 tstd 25 Boph ~~1/2~~ went
 to 98% wth OCT 31 '56 X 500
 NOV 7 '56 NOV 13 '56 sqd All PF co
 RePF 28/4329-36 1/2 1 Bw
 ph Frac \$ 8 Boph 6 hrs
 decreased to 99% wth.

D & A.