


Section 20 Township 27 Range 13W

Well No. #1 Moon

Company Musgrove Pet.

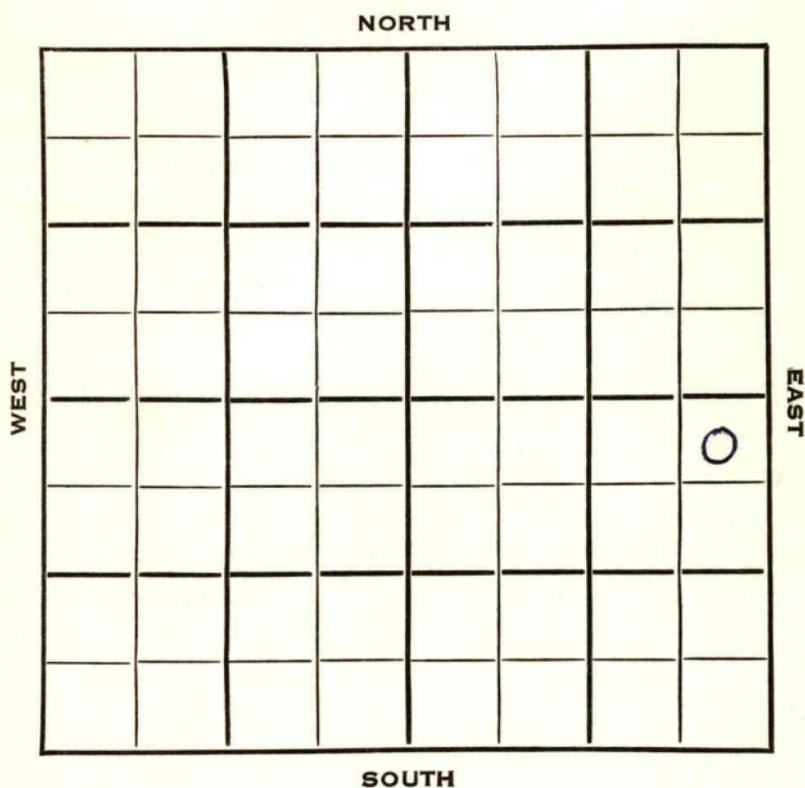

Pratt

KANSAS

SEC.	TWP.	R.
20	27	13 W

WELL NO.

COMPANY # 1 Moon FARM

CONTRACTOR Musgrove Pet.


Wildcat

330 Ft. from N. Line

Ft. from S. Line

330 Ft. from E. Line

Ft. from W. Line

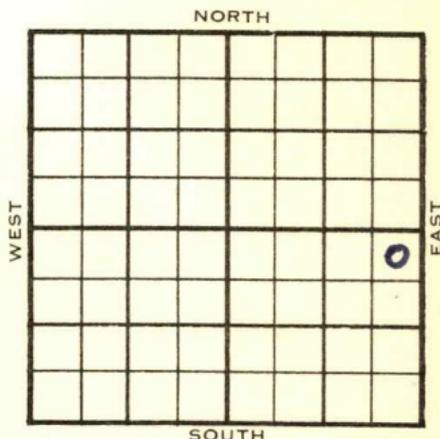

NE NE SE
Phillips Farmout
NCRA - DHM

	ELEVATION	REPORT
1953	1940'	

12/9	Spud 12-2-53 8" @ 322 Drlg. 1630'
12/16	Heeb 3683', Br. L. 3834', Lans 3860' Drlg 4025'
12/22	Spud 12-2-53 D & A TD 4597' 8" @ 322' Heeb 3683', Br. Lime 3834', Lans 3860' Cong 4286', Miss 4319', Kh 4336', Viola 4360', Simp 4439', Arb 4554' TD 4597' D & A

ABANDONED

