


Section 24 Township 27 Range 13 W

Well No. # 1 J. J. Helmke

Company Stanolind

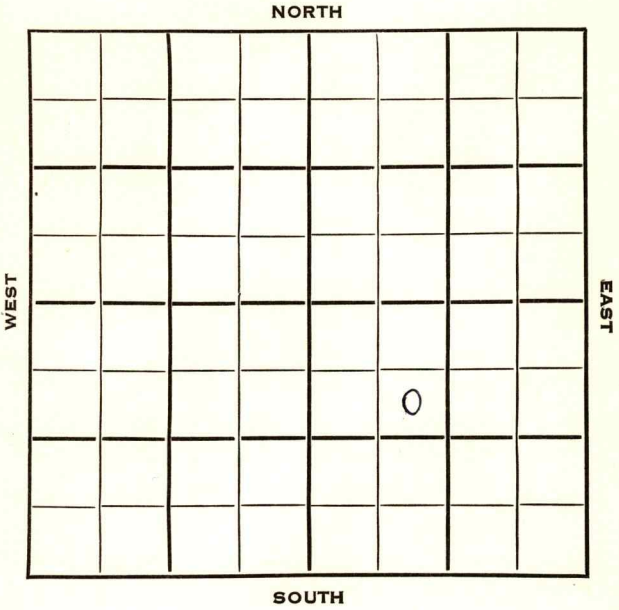

SEC.	TWP.	R.
24	27	13W


WELL NO. 1 J. J. Helmke FARM

COMPANY Stanolind

CONTRACTOR

Tuka-Carmi Pool

990 Ft. from N. Line  
 \_\_\_\_\_ Ft. from S. Line  
 \_\_\_\_\_ Ft. from E. Line  
 990 Ft. from W. Line

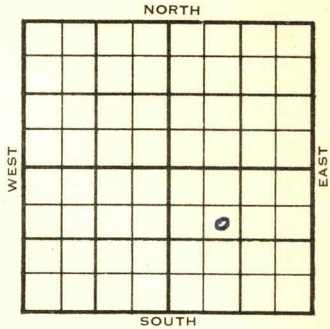

SE NW SE

	ELEVATION	REPORT
1953	1897'	

12/2 Location  
 12/9 "

1954  
 1/6 8" @ 686'  
 Drlg 3325'

1/13 **Lans 3758'**,  
 DST 3789'-3806' 1 hr, 70' gas, 50' wcm  
 257#  
 DST 3991'-4026' 1 hr, 70' gas, 2150' SW  
 1480#  
**B KC 4099', Miss 4207'**  
 Drlg 4237'

1/20 Cored 4300-60', ~~XXXXX~~  
**Simp Sha 4323'** **Simp sd 4349'**  
 DST 4349-60, 2 hrs, 30' SO & GCM  
 53# **Arb. 4429'** RTD 4460'  
 Schl 5" @ 4459

OVER

1954

1/27

Spud 12-28-53

D&A

TD 4460'

8" @ 686'

Lans 3758'

DST 3789-3806', opn 1 hr., rec. 70'  
gas, 50' wcm, 257#

DST 3991-4026', opn 1 hr., rec. 70'  
gas, 2150' sw, 1480#

B KC 4099', Miss 4207', Simp sh.  
4323', Simp sd 4349'

DST 4349-60', opn 2 hrs., rec. 30'  
so & gcm, 53#

Arb. 4429'

TD 4460

5" @ 4459'

CO to 4379

24/4349-53

S<sup>d</sup>-oil-frac

S/2 bw  $\frac{1}{2}$  boph

D&A

**ABANDONED**



